

Name **Lawrence P. Benjamin**

Service No. **129**

Address **11 Douglas Road**

lot 28

Location

Kind of Pipe

Size

Size of Main

Repair—Renewal—**New Service Valeri #1777**

Location **DEC 31 1970**


Date	Material	Amount	Total	Date	Amount
11/17/70	6" Transite pipe @7.50		202.50	11-10-70	<i>Deposit</i>
11/17/70	40' 6" Transite pipe			1-29-71	<i>Paid</i>
	10' 4" Cast. Iron pipe				7.50
					202.50
				11- - 70	
				26'	6" Transite
				1	6" - 22° Sweep

DATE _____

TOWN OF LEXINGTON — BOARD OF PUBLIC WORKS

SEWER DIVISION

Sketch of Service Here **11**

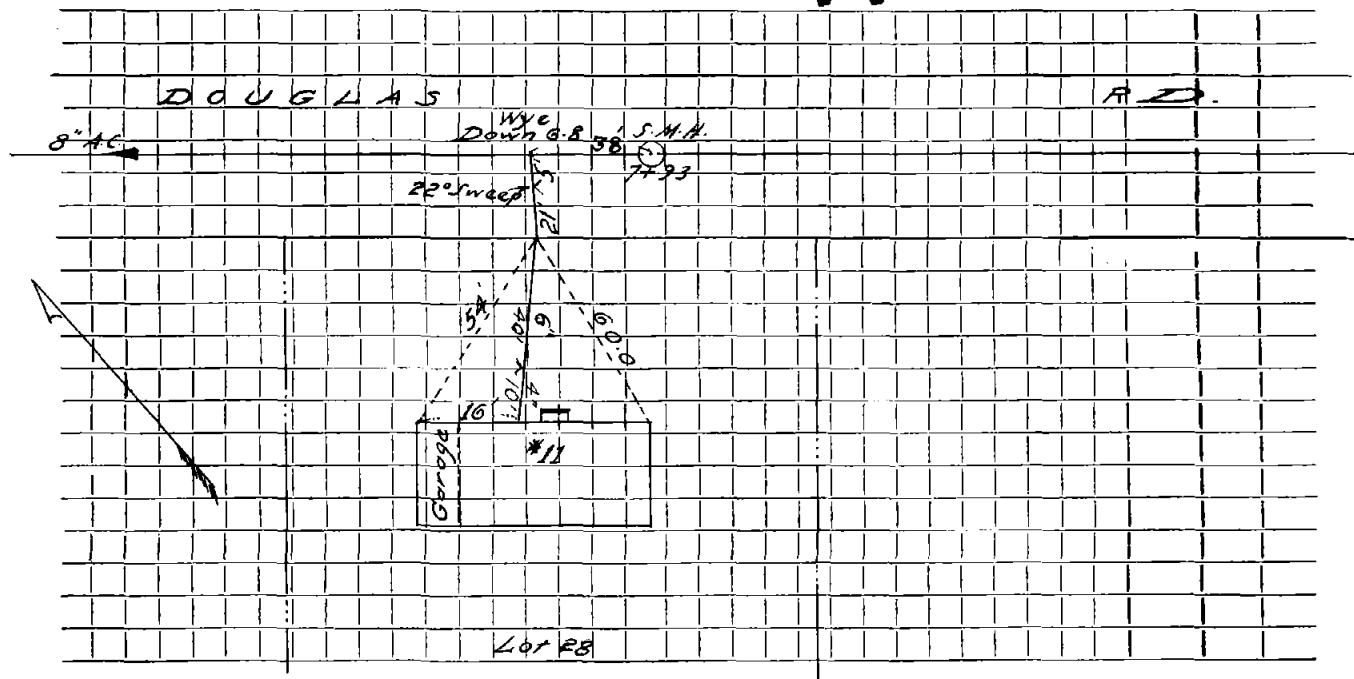

Connection made in Street. Work completed

Remarks:

.....

.....