

Name

Service No.

Address 17 Douglas RD

LOT 26

Location

Kind of Pipe

Size

Size of Main

Repair Renewal New Service

Tocci

Location


Date	Material	Amount	Total	Date	Material	Amount
11/17/70	5' 4" CIP					
EXISTING	25' 6" AC-PIPE TO CO. MANHOLE			11/16/70	29' 6" TRANSITE	
					1 6" 11 1/4" BEND	
3/30/99	82' 6" PVC					
	1 6" WYE CLEAN OUT					
	2 6" 75° BENDS					
	2 6" AC X PVC FENCE					

DATE _____

TOWN OF LEXINGTON — BOARD OF PUBLIC WORKS

SEWER DIVISION

Sketch of Service Here

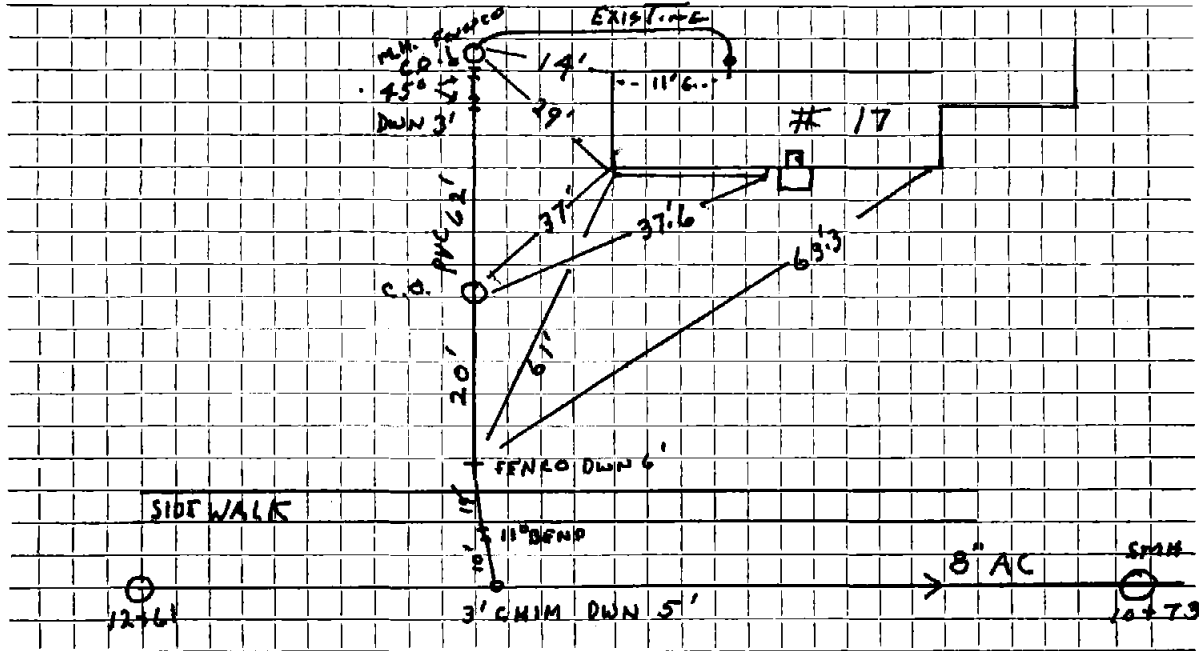

Connection made in Y.D. JUST BEHIND S.W. Street. Work completed

Remarks:
.....
.....