

Name **George Sargent**

Service No. **119**

Address **18 Douglas Road**

**Location**

**Kind of Pipe**

**Size**

**Size of Main**

**Repair—Renewal—New Service Valeri #1768**

**Location DEC 31 1970**

Date	Material	Amount	Total	Date	Amount
Nov/1970	<del>28'</del> 6" <del>Transite</del> pipe @	7.50	\$195.00	11-3-70	187.50
11/12/70	129' 6" Transite pipe			11-9-70	7.50
	4' 4" Cast Iron pipe				195.00
				11- -70	
				25' 6" Transite	
				1 6"-11° Bend	


DATE \_\_\_\_\_

TOWN OF LEXINGTON — BOARD OF PUBLIC WORKS

SEWER DIVISION

Sketch of Service Here

18

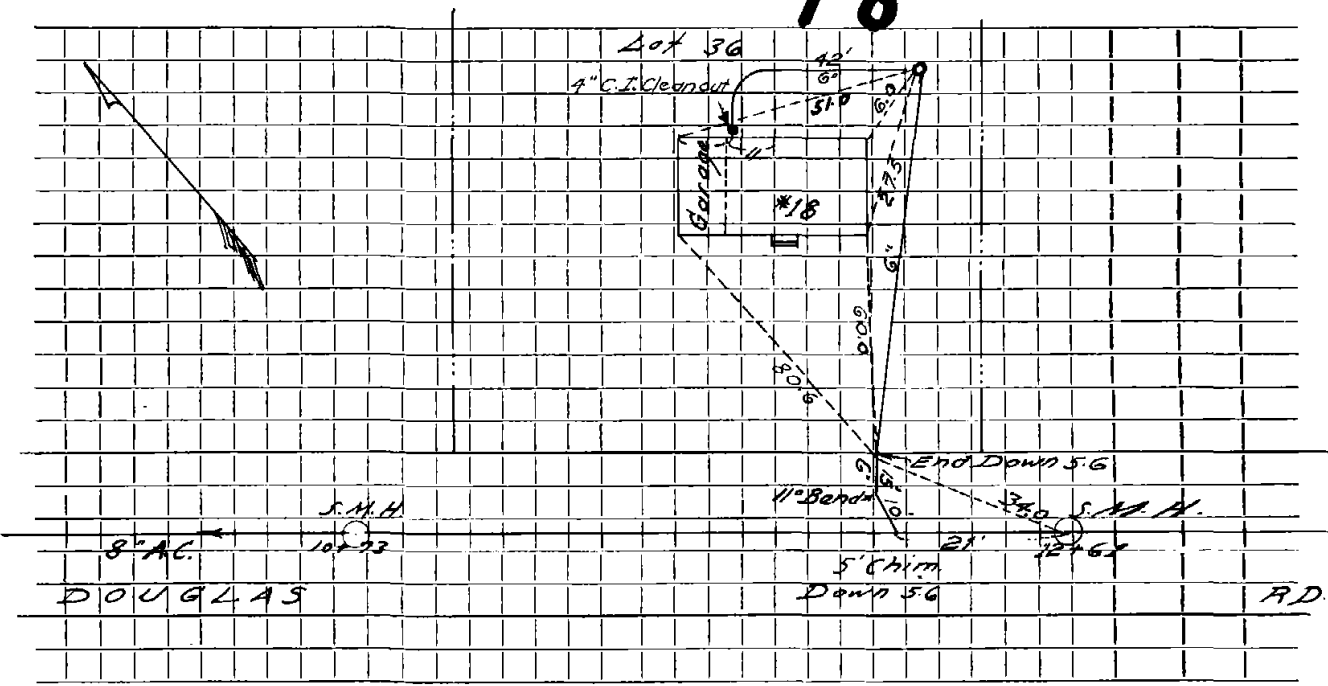

Connection made in ..... Street. Work completed .....

Remarks: .....  
.....  
.....