

Name Leonard G. Abraham Jr.

Service No. 134

Address 19 Douglas Road

Location

Kind of Pipe

Size

Size of Main

Repair—Renewal—New Service Valeri #1782

Location DEC 31 1970


Date	Material	Amount	Total	Date	Amount
Nov/1970	27' 6" Transite pipe	@ 7.50	\$202.50	11-11-70	202.50
1/17/70	105' 6" Transite pipe				
	12' 4" Cast. Iron pipe				
				11- - 70	
				27' 6" Transite	

DATE _____

TOWN OF LEXINGTON — BOARD OF PUBLIC WORKS

SEWER DIVISION

Sketch of Service Here **19**

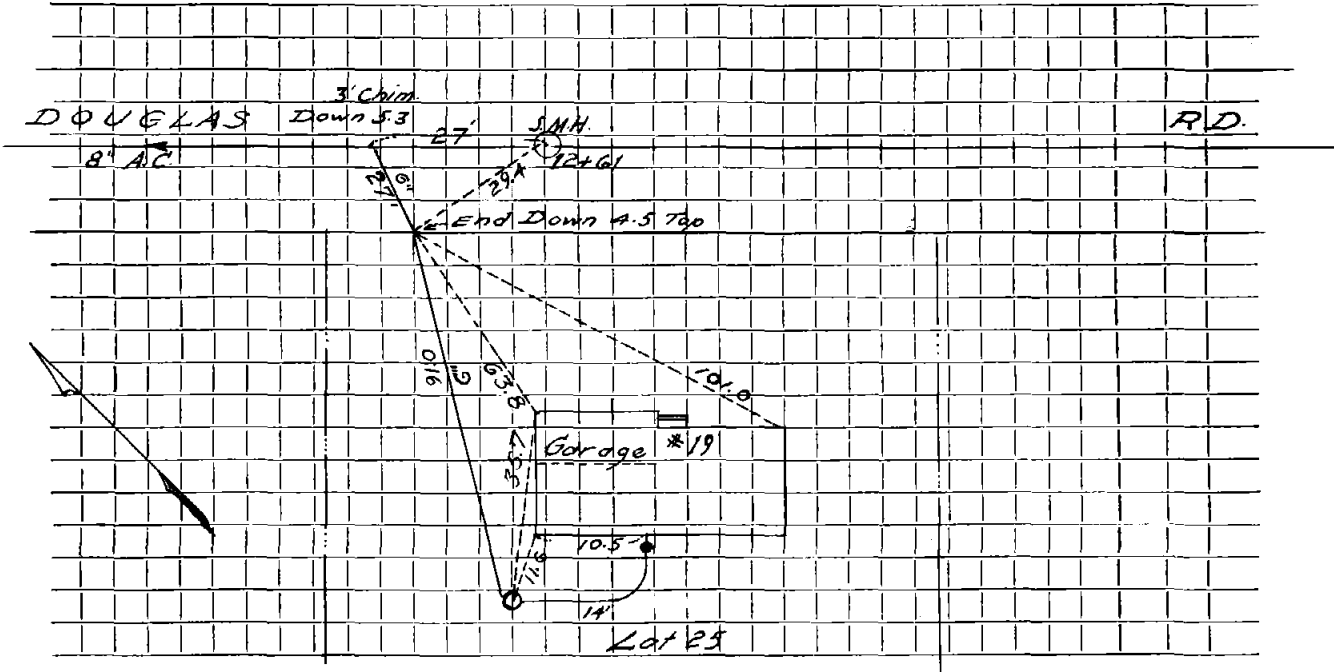

Connection made in Street. Work completed

Remarks:
.....
.....