

Name John Stennes

Service No. 124

Address ~~253 East Street~~ 2 Douglss

Lot 3

Location

Kind of Pipe

Size

Size of Main

Repair—Renewal—New Service Valeri #1979

Location JUN 5 1972

Date	Material	Amount	Total	Date	Amount
Nov '70	<del>19' 6" Transite pipe @7.50</del>		142.50	11-6-71	Deposit
12-8-71	56' 6" Transite pipe				
	30' 4" Cast Iron pipe				
				11- - 70	
				19' 6" Transite	
3/17/00	8' - 4" PVC				
	1 4x6 ferroc PVC to PVC				
	5' 6" PVC				
	1 6x6 PVC to AC				

TOWN OF LEXINGTON — BOARD OF PUBLIC WORKS


SEWER DIVISION

DATE

4x6  
6x6 AC  
PVC

Sketch of Service Here

253

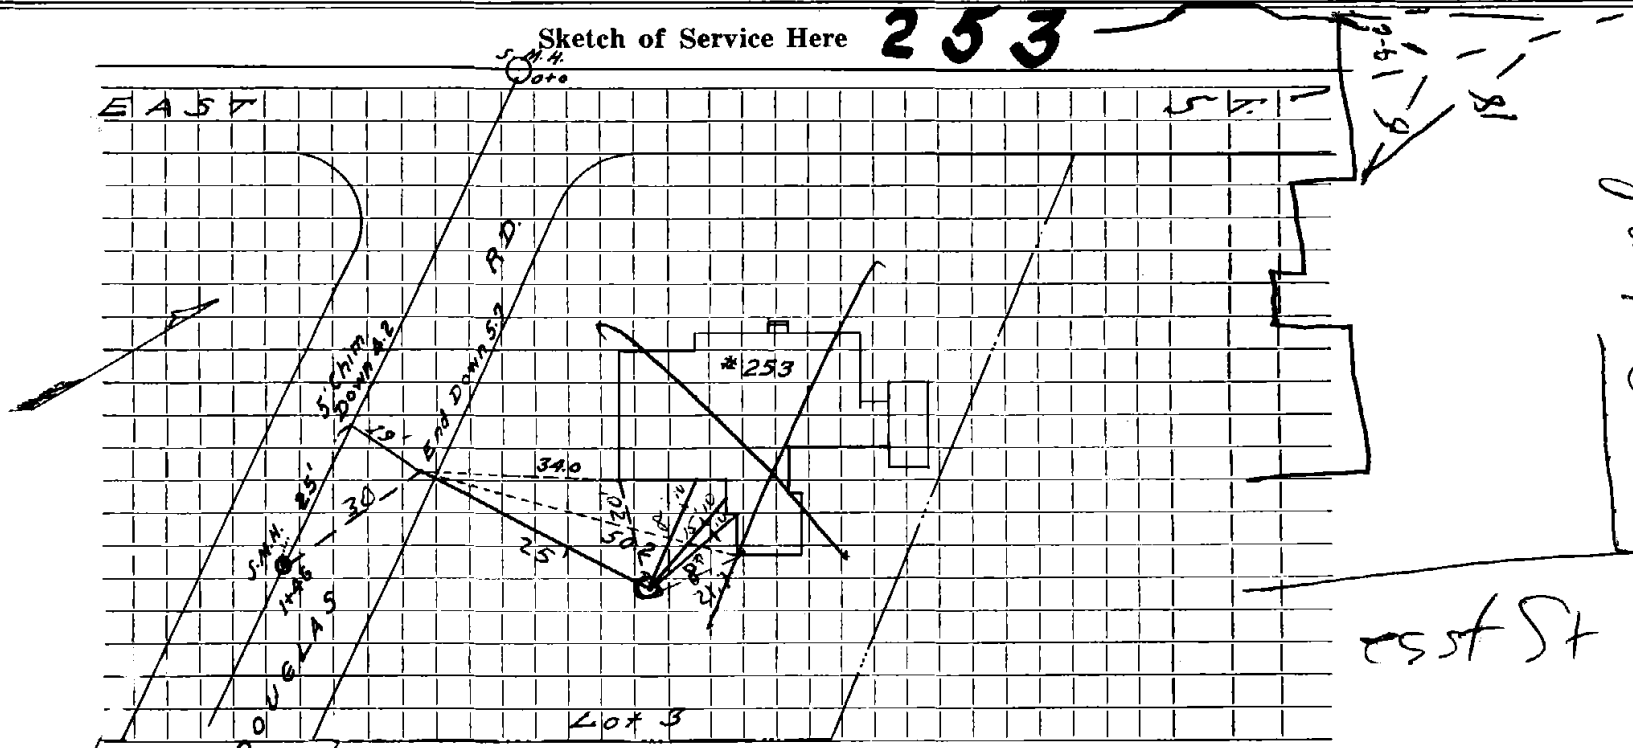

Connection made in Days St. Street. Work completed .....

Remarks: old house torn down new house

Darker Red

East St