

Name

Service No.

Address

24 Douglas Road

Location

Kind of Pipe

Size

Size of Main

Repair—Renewal—New Service


Location

Date	Material	Amount	Total	Date	Amount
10/1970	21' - 6" Transite pipe @	7.50	\$157.50		
				11 - - 70	
				21' 6" Transite	

DATE \_\_\_\_\_

TOWN OF LEXINGTON — BOARD OF PUBLIC WORKS  
SEWER DIVISION

Sketch of Service Here **24**

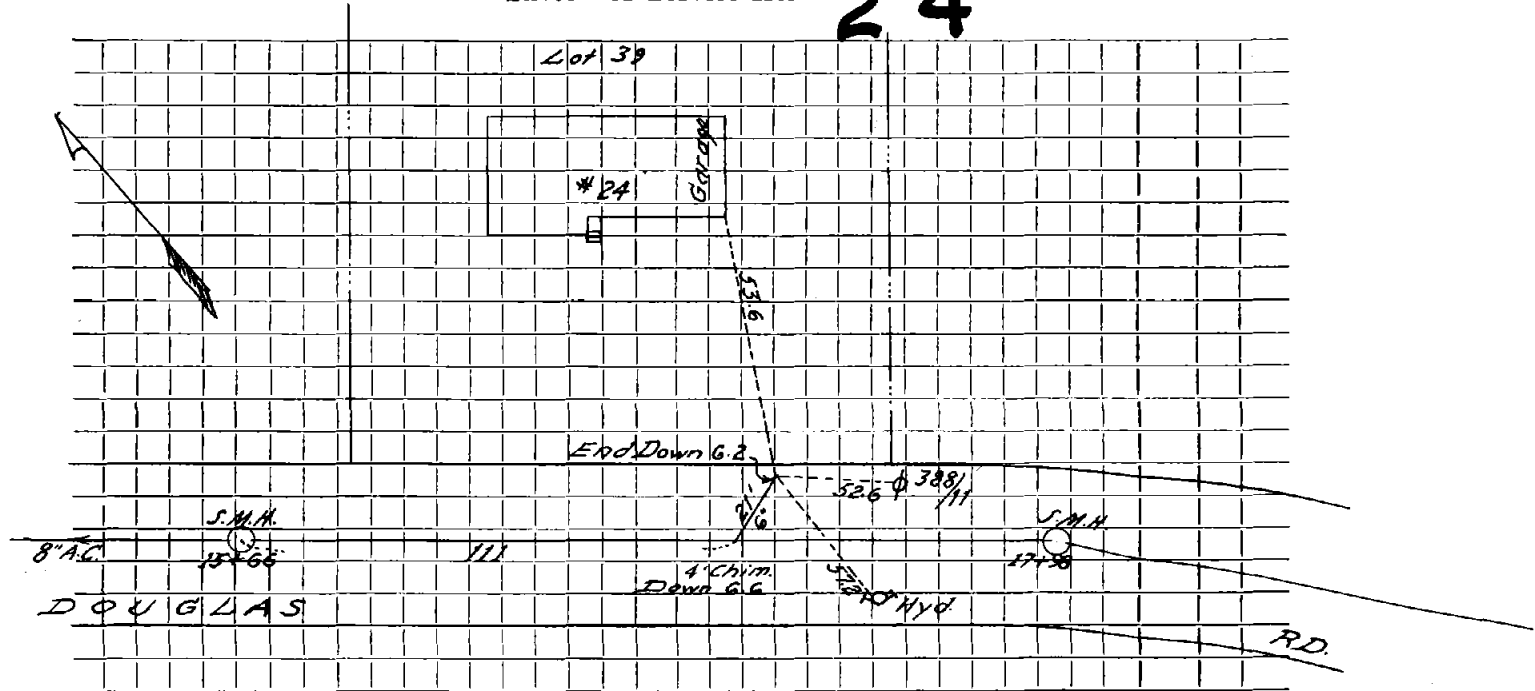

Connection made in ..... Street. Work completed .....

Remarks: .....

.....

.....