


DATE Nov 1970

TOWN OF LEXINGTON — BOARD OF PUBLIC WORKS

SEWER DIVISION

Sketch of Service Here **26**

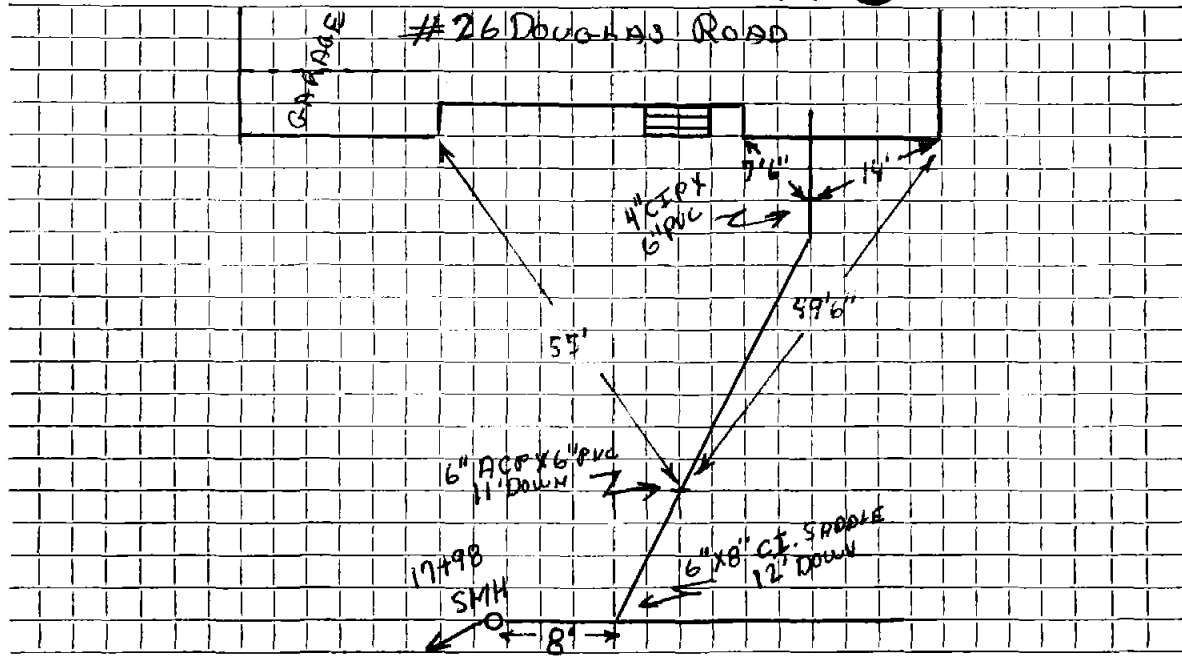

Connection made in Douglas Road Street. Work completed Nov. 27, 1984

Remarks:

.....

.....