


DATE OCT 17 1997

TOWN OF LEXINGTON — BOARD OF PUBLIC WORKS

SEWER DIVISION

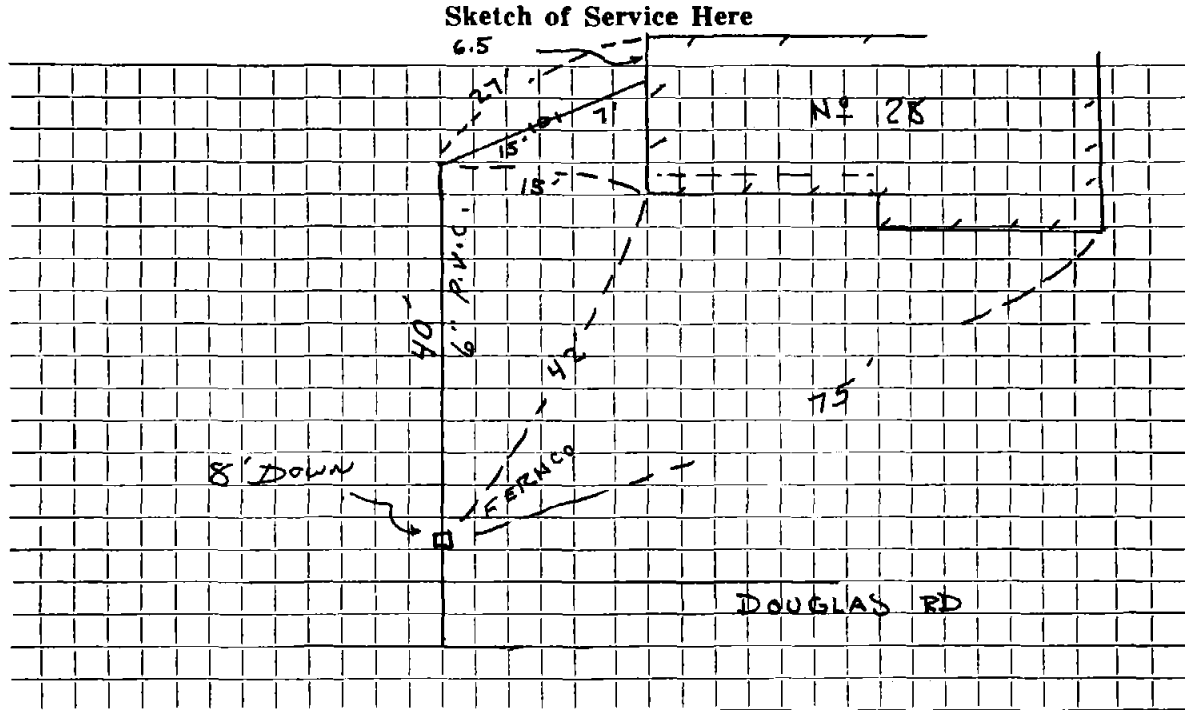

Connection made in DOUGLAS Street. Work completed ROCKWELL CONST.

Remarks:

.....


..... FIELD BOOK 97-4 TJM

DATE _____

TOWN OF LEXINGTON — BOARD OF PUBLIC WORKS

SEWER DIVISION

Sketch of Service Here **28**

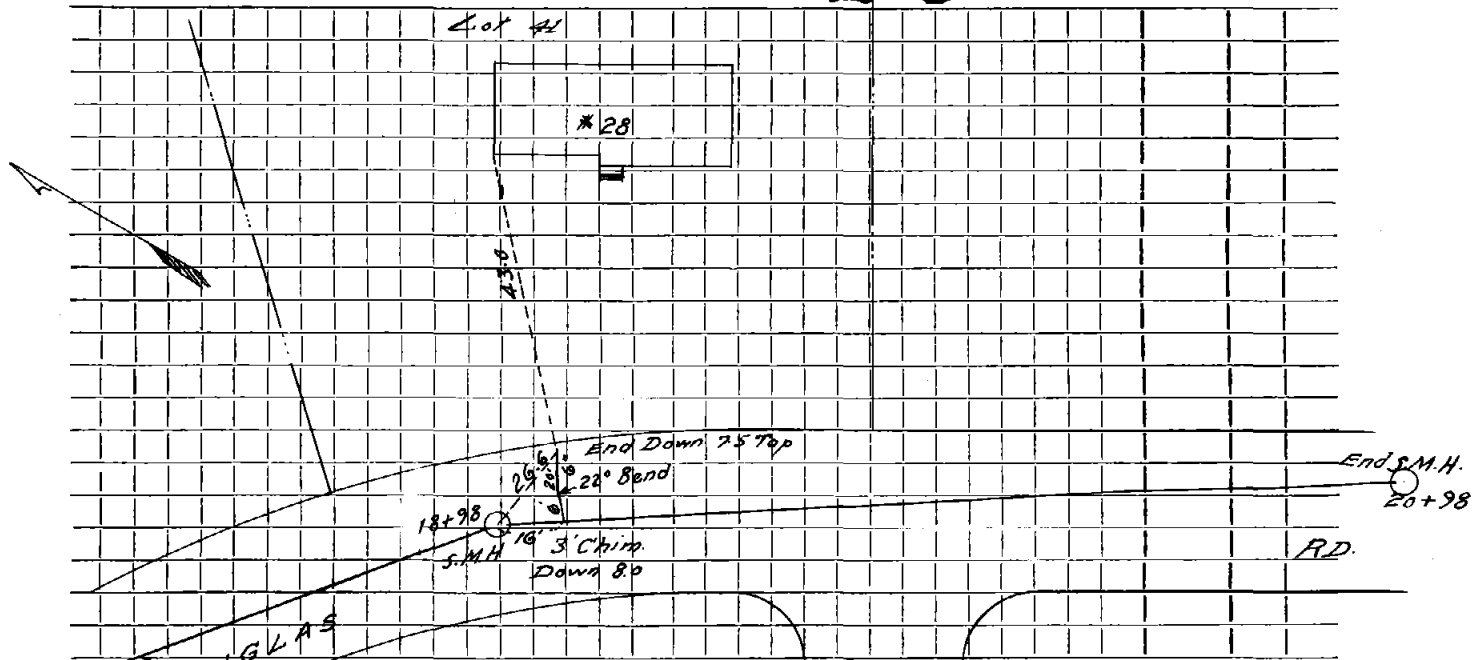

Connection made in 8" A.C. DOUGLAS Street. Work completed

Remarks: _____
