

Name **Ned Donato**

Service No. **136**

Address **30 Douglas Road**

Location

Kind of Pipe

Size

Size of Main

Repair—Renewal—New Service **Valeri #1784**

Location **DEC 31 1970**

Date	Material	Amount	Total	Date	Amount
<del>Nov/1970</del>	<del>13' - 6" Transite pipe</del>	<del>@ 7.50</del>	<del>\$97.50</del>	<del>11-17-70</del>	<del>97.50</del>
11/17/70	56' 6" Transite pipe				
	10' 4" Cast Iron pipe				
				11- -70	
				13' 6" Transite	
				8-27-78	Solds


DATE \_\_\_\_\_

TOWN OF LEXINGTON — BOARD OF PUBLIC WORKS

SEWER DIVISION

Sketch of Service Here

30

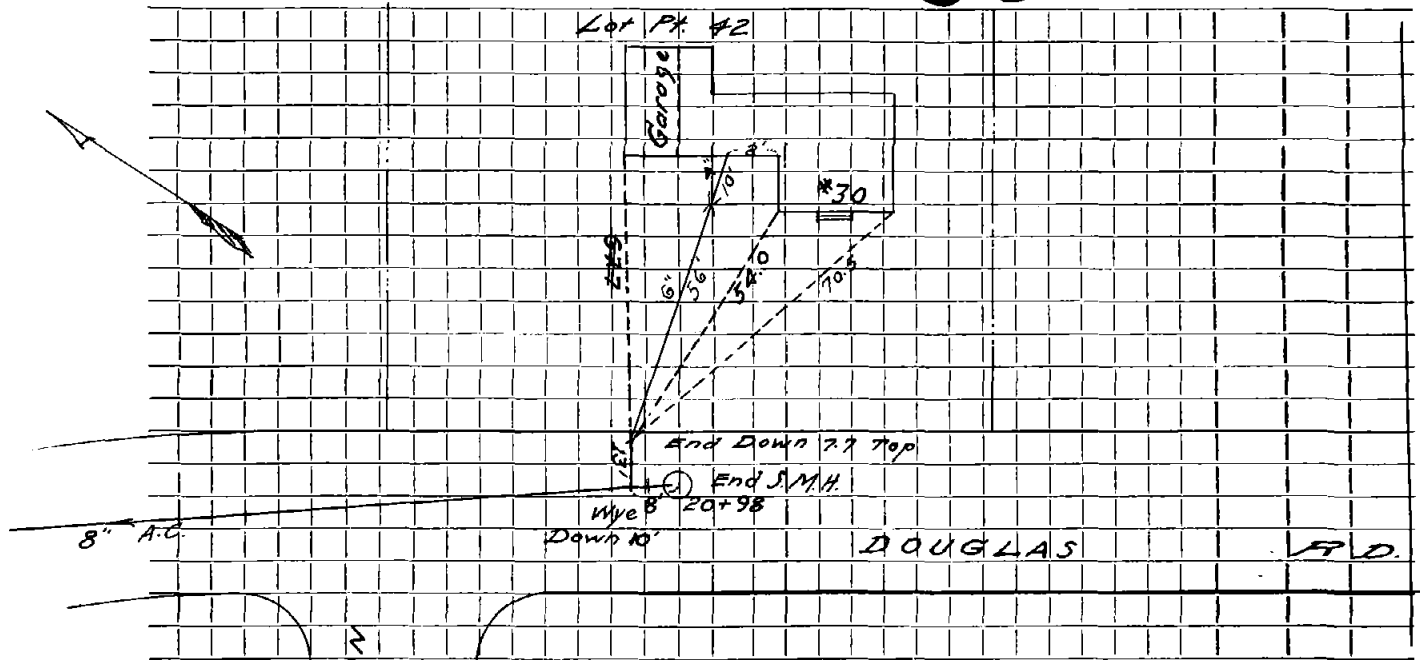

Connection made in ..... Street. Work completed .....

Remarks: .....

.....

.....