

Name Martha Soshnick

Service No. 121

Address 4 Douglas Road

lot 30

Location

Kind of Pipe

Size

Size of Main

Repair—Renewal—New Service Valeri #1771

Location DEC 31 1970

Date		Material	Amount	Total	Date	Amount
Nov 170	21'	6" Transite pipe @	7.50	157.50	11-4-70	150.00
1/10/70	50'	6" Transite pipe			1-27-71	7.50
	10'	4" Cast Iron pipe				157.50
					11- - 70	
					20' 6" Transite	
					1 6"-30° Bend	


Deposit Paid

DATE _____

TOWN OF LEXINGTON — BOARD OF PUBLIC WORKS

SEWER DIVISION

Sketch of Service Here **4**

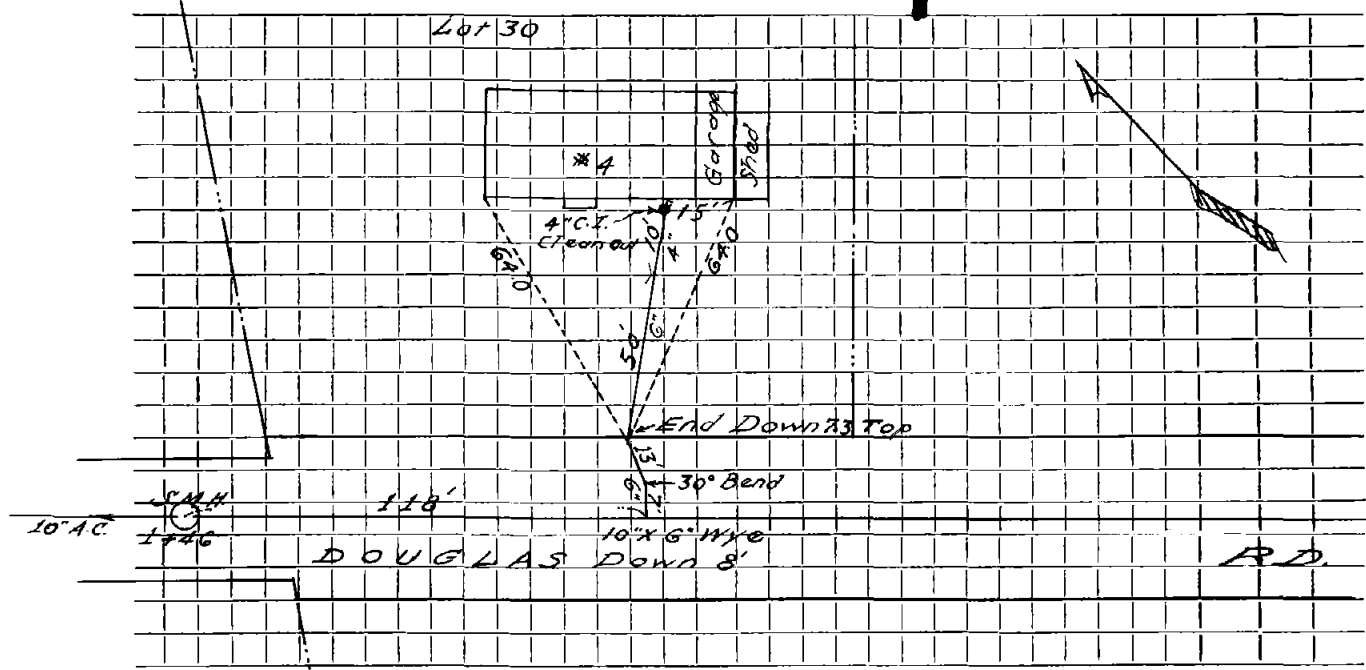

Connection made in Street. Work completed

Remarks:
.....
.....