




DATE \_\_\_\_\_

TOWN OF LEXINGTON — BOARD OF PUBLIC WORKS

SEWER DIVISION

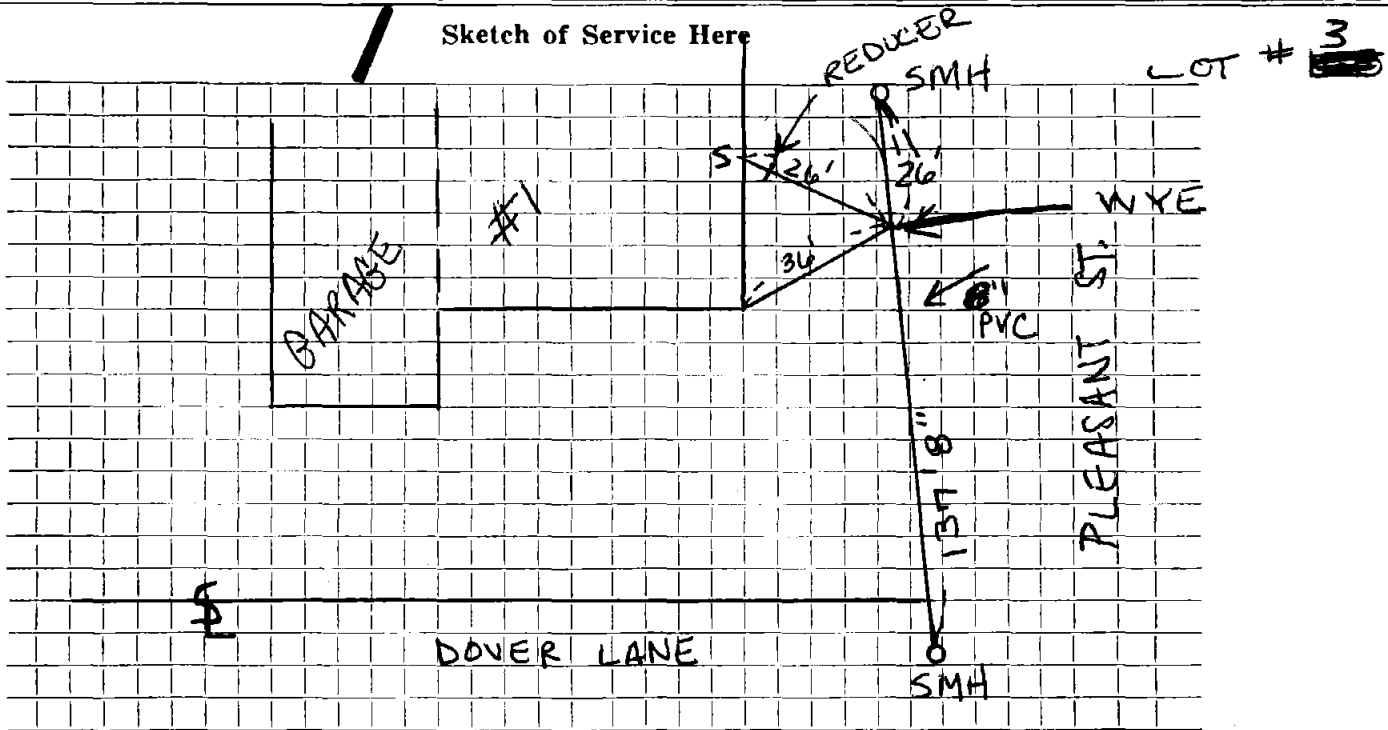

Connection made in EASEMENT DOVER LANE Street. Work completed .....

Remarks: ~~XXXX~~ ~~XX~~ ~~XXXX~~ ~~XX~~ .....

.....  
.....