

Name

Service No.

Address #<sup>10</sup>~~5~~ Dover Lane

Location

Kind of Pipe PVC

Size 6"

Size of Main 8" PVC

Repair—Renewal (New Service)


Location

Date	Material	Amount	Total	Date	Amount
<del>Aug. 86</del>	<del>① 8" x 8" x 6" wye</del>				
	<del>② 22° bend 6"</del>				
	<del>52' 6" of 6" PVC</del>			8- - 86	
				52' 6" P.V.C.	
12/20 88	66' 6" PVC			1 6"- 22° Bend	
	FERNCO			1 8" x 8" x 6" Wye	
	6' C.I.				

DATE \_\_\_\_\_

TOWN OF LEXINGTON — BOARD OF PUBLIC WORKS  
SEWER DIVISION

Sketch of Service Here **10**

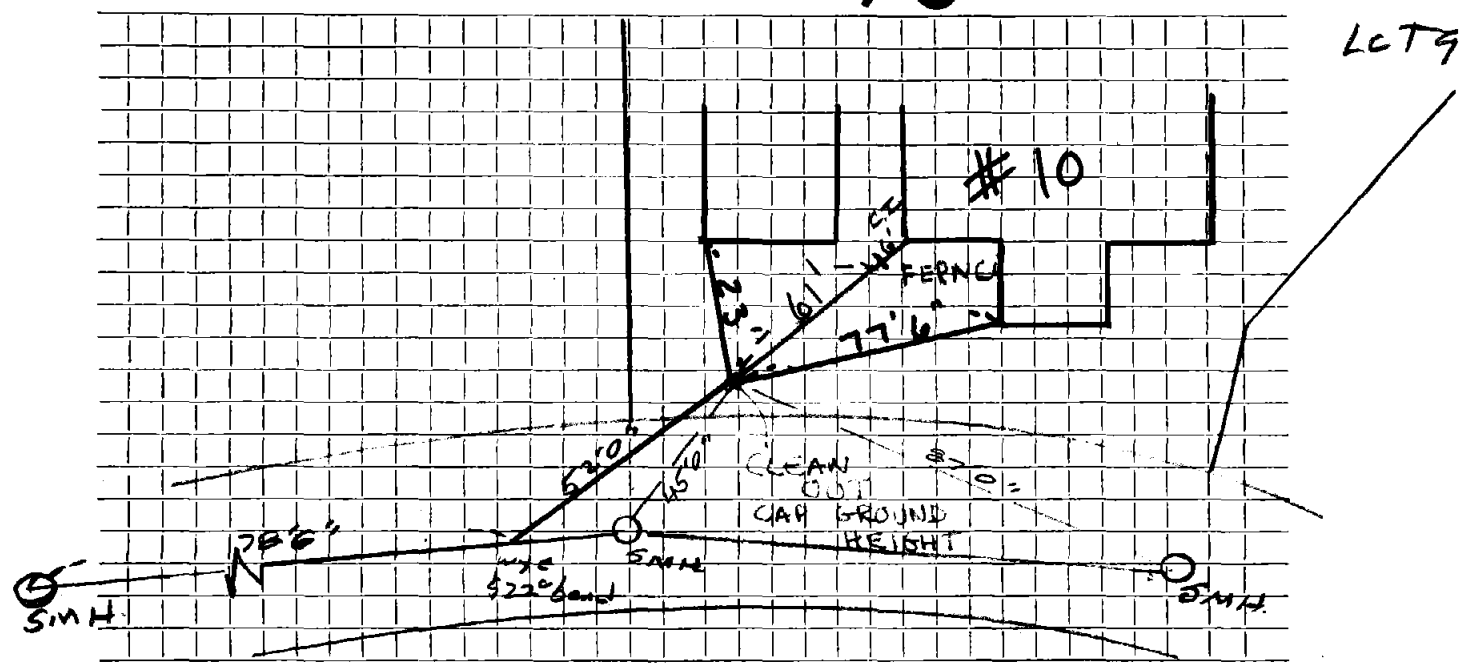

Connection made in ..... Street. Work completed .....

Remarks: .....  
.....  
.....