

Name

Service No.

Address

~~#11~~ Dover Lane

Location

Kind of Pipe

PVC

Size

6"

Size of Main

8" PVC

Repair—Renewal

(New Service)

Location

Date

Material

Amount

Total

Date

Amount

~~Aug 86 486' of 6" PVC.~~

8- - 86


48' 6" P.V.C.

DATE _____

TOWN OF LEXINGTON — BOARD OF PUBLIC WORKS

SEWER DIVISION

Sketch of Service Here

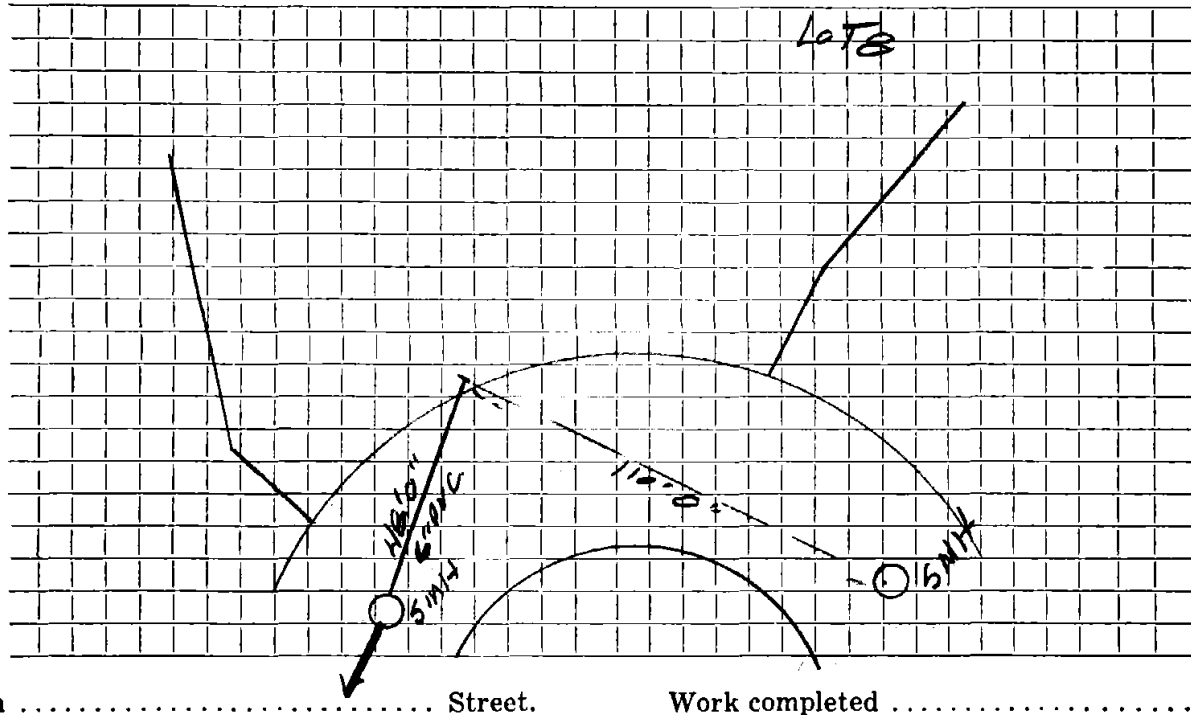

Connection made in Street. Work completed

Remarks:

.....

.....