

Name

Service No.

Address # ~~1~~ 3 Dover Lane

(EXIST. HOUSE #91 PLEASANT ST.)

Location

Kind of Pipe PVC

Size 6"

Size of Main 8" PVC

Repair—Renewal (New Service)

Location

Date

Material

Amount

Total

Date

Amount

Aug 4, 86

① 6" saddle  
① 6" 22" band  
45' 0" of 6" PVC.

NOTE


Hse. has two septic tanks both are to be connected

DATE \_\_\_\_\_

# TOWN OF LEXINGTON — BOARD OF PUBLIC WORKS

## SEWER DIVISION

**3** Sketch of Service Here

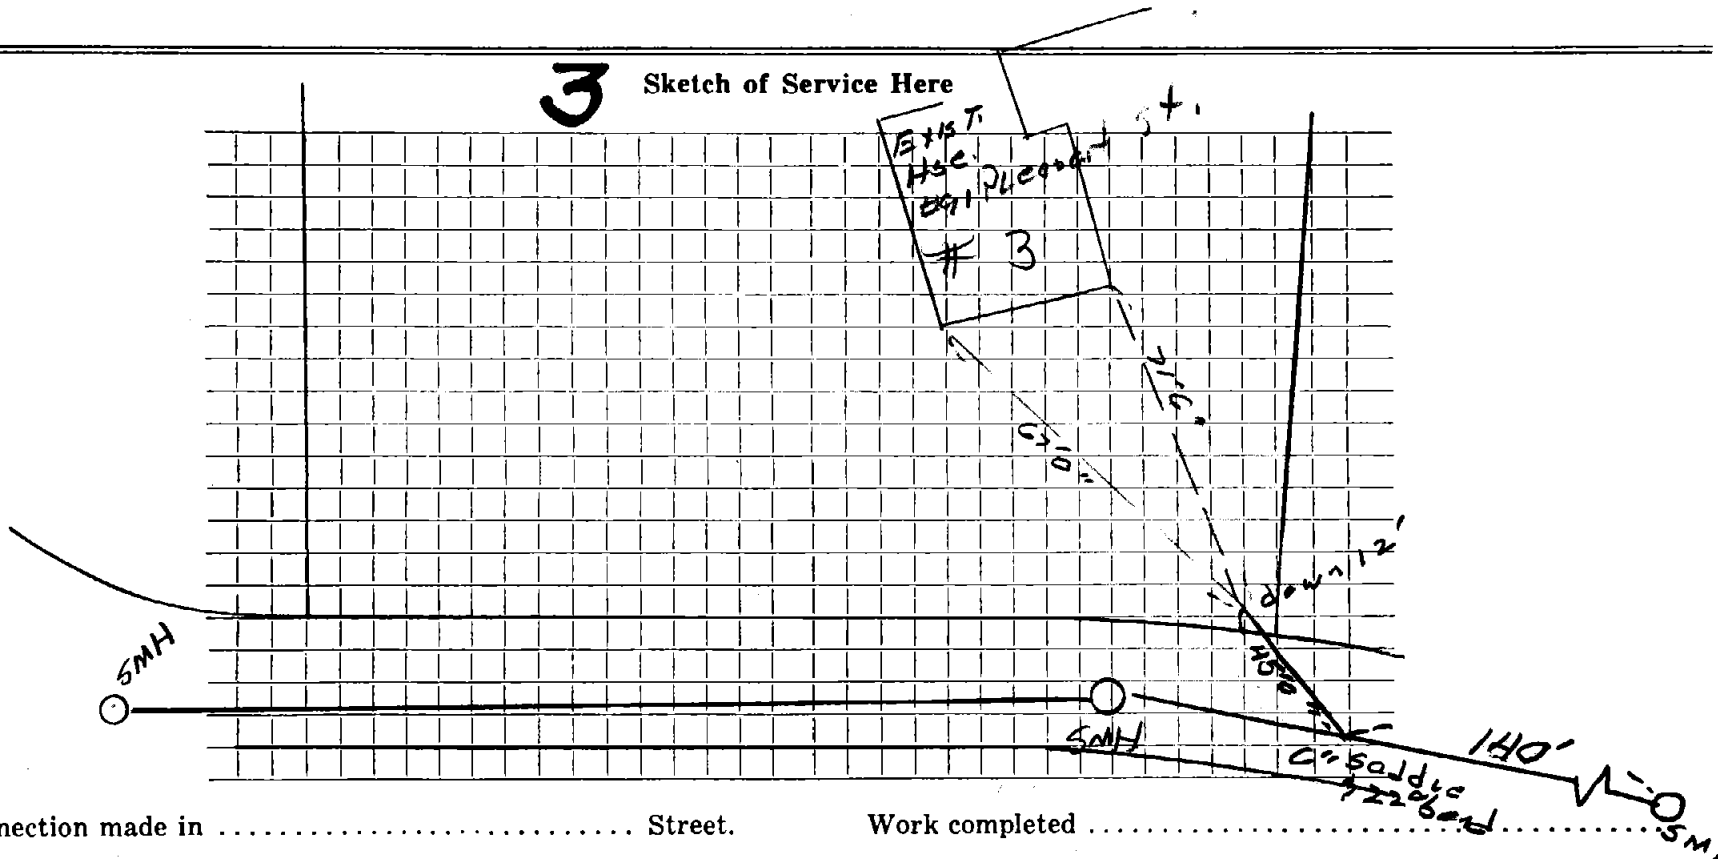

Connection made in ..... Street.

Work completed ..... SMH

Remarks: .....  
.....  
.....