

Name

Service No.

Address

6 Dover Ln

Location

Kind of Pipe

Size

Size of Main

Repair—Renewal—New Service

Location

Date

Material

Amount

Total

Date

Amount

10.30.01

Pump system put in  
for REAR SECTION of house


Pump and chamber  
140' - 1 1/4" PVC  
1- m. h.  
39' - 6" PVC

DATE \_\_\_\_\_

# TOWN OF LEXINGTON — BOARD OF PUBLIC WORKS

## SEWER DIVISION

Sketch of Service Here

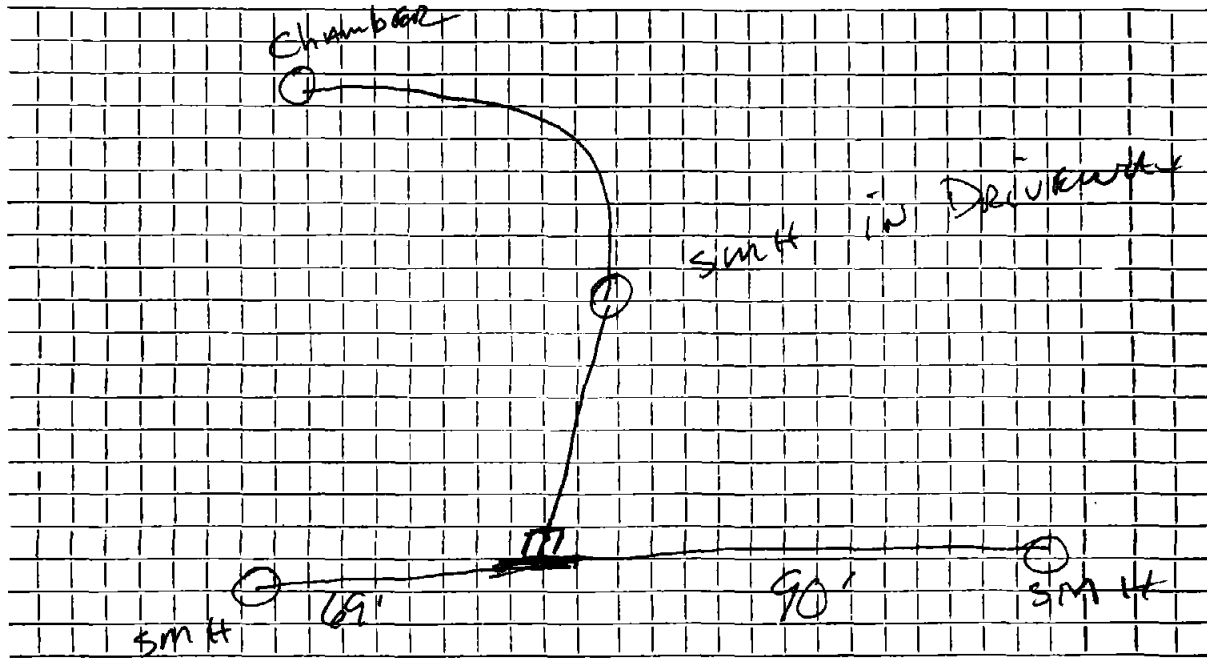

Connection made in ..... Street. Work completed .....

Remarks: .....

System comes out to Dover Ln




DATE \_\_\_\_\_

TOWN OF LEXINGTON — BOARD OF PUBLIC WORKS

SEWER DIVISION

Sketch of Service Here

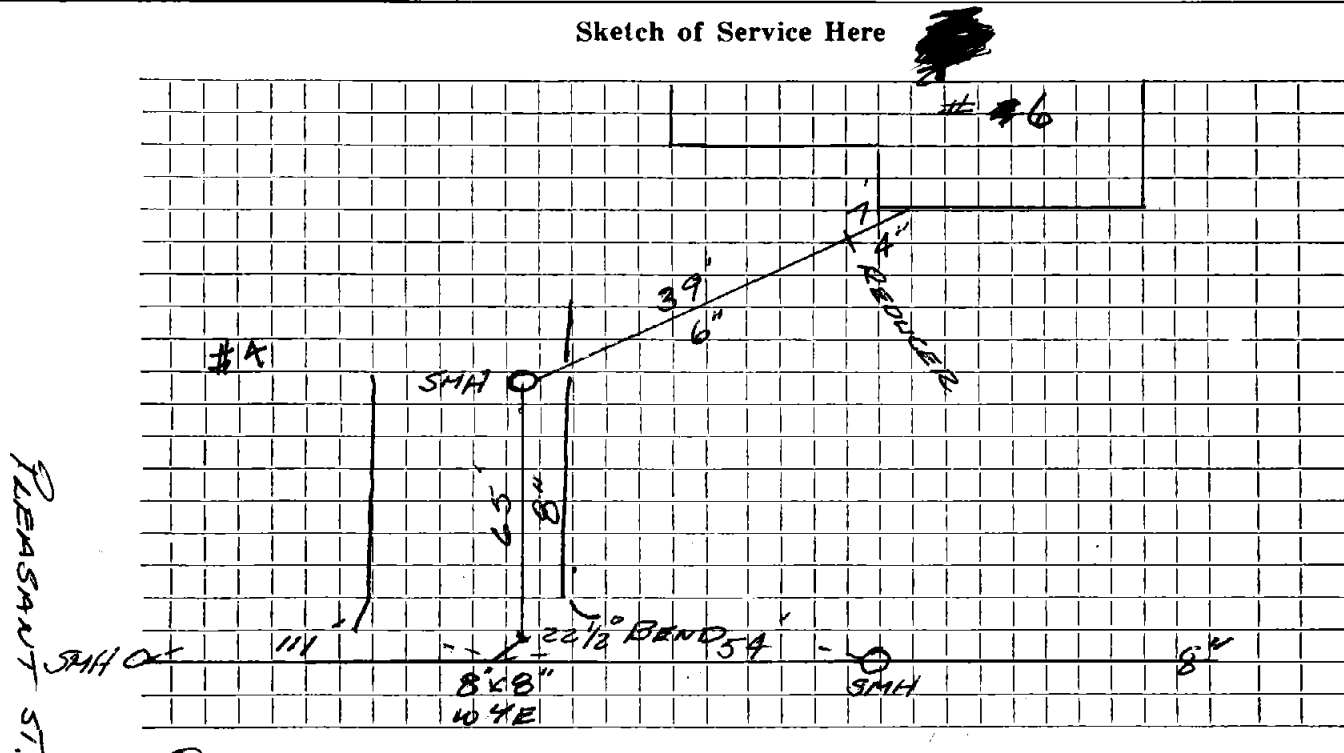

Connection made in DOVER LANE Street. Work completed .....

Remarks: .....