

Name

7

Service No.

Address # ~~1~~ Dover Lane

Location

Kind of Pipe

PVC

Size

6"

Size of Main 8" PVC.

Repair—Renewal

(New Service)

Location

Date

Material

Amount

Total

Date

Amount

Aug. 11, 86

47' 6" of 6" PVC

Dec. 29, 86

① 6" 22° bend

① 6" x 4" Fernco reducer

69' of 6" PVC


8" 11' 4" "

DATE \_\_\_\_\_

TOWN OF LEXINGTON — BOARD OF PUBLIC WORKS

SEWER DIVISION

Sketch of Service Here **7**

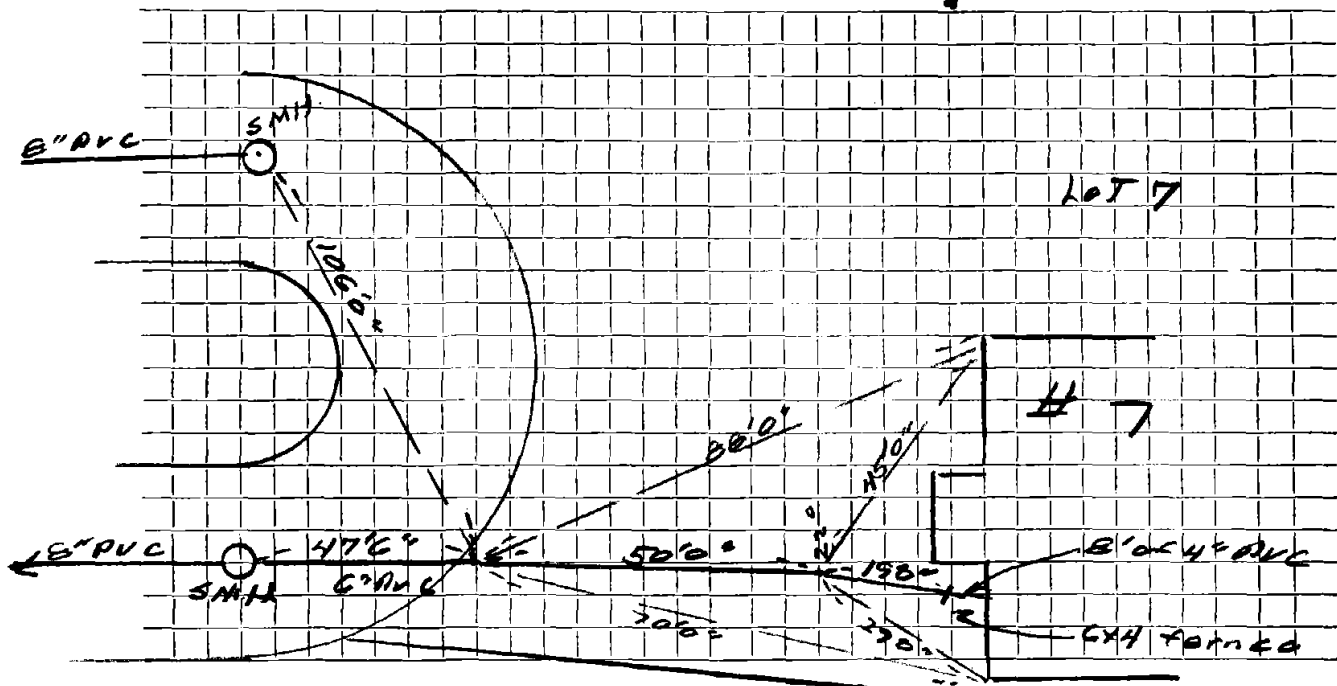

Connection made in ..... Street. Work completed .....

Remarks: .....  
.....  
.....

Name

Service No.

Address # <sup>74</sup>/<sub>8</sub> Dover Lane

Location

Kind of Pipe

PVC

Size

6"

Size of Main 8" PVC

Repair—Renewal—(New Service)

Location

Date

Material

Amount

Total

Date

Amount

Aug. 4, 86

① 8x8x6" wye

① 22° bend 6"

56'0" of 6" PVC.

Dec. 15, 86

① Fernco 6"x4" reducer


36'0" of 6" PVC.

10'0" " 4" "

DATE \_\_\_\_\_

TOWN OF LEXINGTON — BOARD OF PUBLIC WORKS  
SEWER DIVISION

Sketch of Service Here

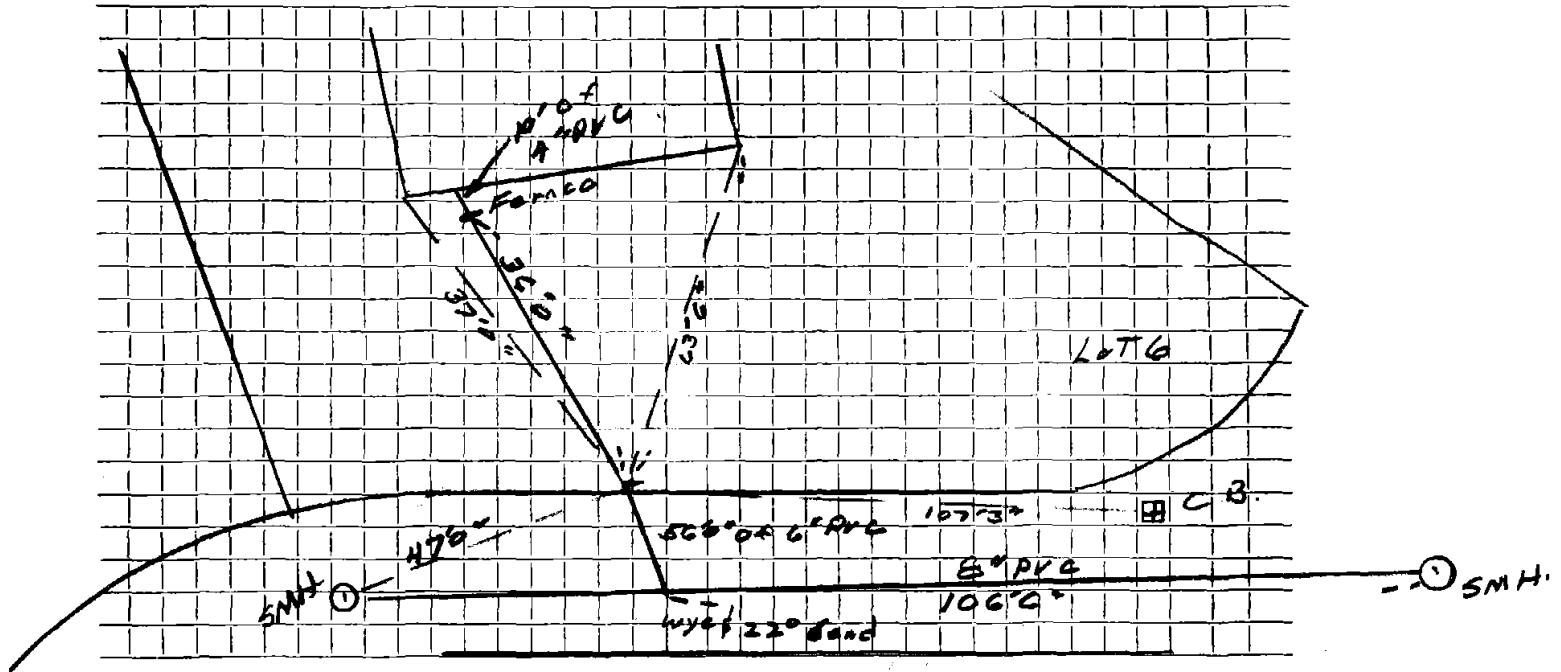

Connection made in ..... Street. Work completed .....

Remarks: .....  
.....  
.....