

Name

Service No.

Address # 2 Dover Lane

Location

Kind of Pipe

PVC

Size

6"

Size of Main 8" PVC.

Repair—Renewal

(New Service)

Location

Date	Material	Amount	Total	Date	Amount
------	----------	--------	-------	------	--------

Aug. 4, 86

① 21x6 wye
 ① 22° bend
 60' of 6" PVC

8- - 86

Dec. 29, 86

① 22° bend 6"
 ① 6x4 femco reducer
 64' of 6" PVC
 10' of " 4" "

60' 6" PVC


1 6" - 22° Bend

1 8" X 8" X 6" Wye

DATE _____

TOWN OF LEXINGTON — BOARD OF PUBLIC WORKS

SEWER DIVISION

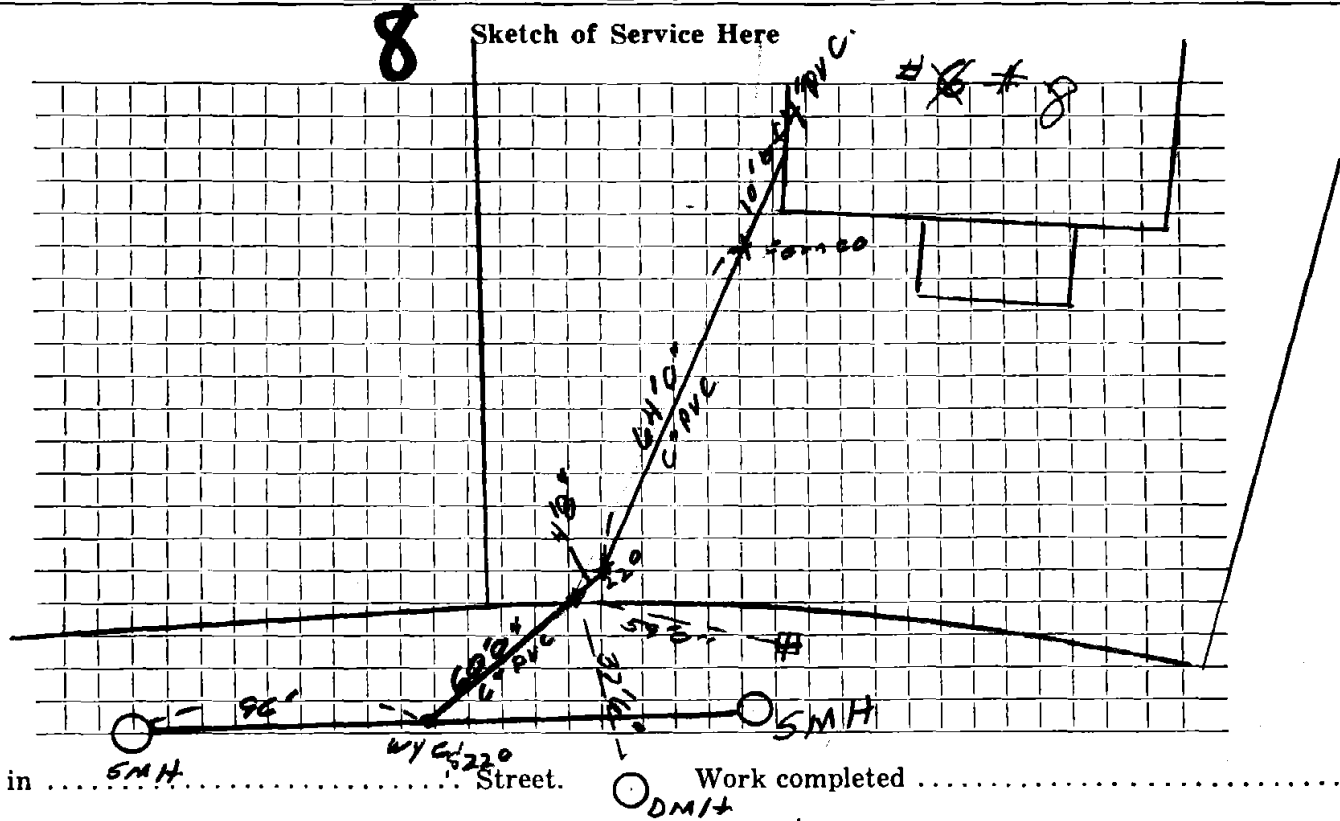

Connection made in
Remarks:

Remarks:

.....

.....