

Name John R. Jones

Service No. 56

Address 11 Downing Road

Location

Kind of Pipe

Size

Size of Main

~~REPAIR TO EXISTING~~ New ServiceLocation *Comm 6-19-61*

| Date | Material | Amount | Total | Date | | Amount |
|--------|--|--------|---------------|---------|----------------|---------------|
| 6-2-61 | Labor | 86.75 | | 5-25-61 | <i>Deposit</i> | <i>210.00</i> |
| | 10% O.H. | 8.68 | 95.43 | 6-19-61 | <i>Retund</i> | <i>22.09</i> |
| | 25 6" Transite pipe @.78 | | 35.10 | | | <i>177.91</i> |
| | 2 11 $\frac{1}{4}$ " Transite Elbows @2.24 | | 4.48 | | | |
| | 1 6" 90° Transite Elbow @5.40 | | 5.40 | | | |
| | 3 Hrs. Town Shovel @6.50 | | 19.50 | | | |
| | 2 Hrs. Trucking @3.00 | | 6.00 | | | |
| | 12 x 3 Patch | | 12.00 | | | |
| | | | <u>177.91</u> | | | |
| | Labor | | | | | |

TOWN OF LEXINGTON—DEPT. OF PUBLIC WORKS
SEWER DIVISION

DATE.....

NO.


The undersigned applies for the construction of a particular sewer connecting No.....
Street and hereby agrees to comply with the Rules and Regulations governing the construction and use of Particular
Sewers, as now or at any future time established by the Board of Selectmen.

Am't of estimate \$.....

Am't Paid \$.....

..... Owner

Sketch of Service Here

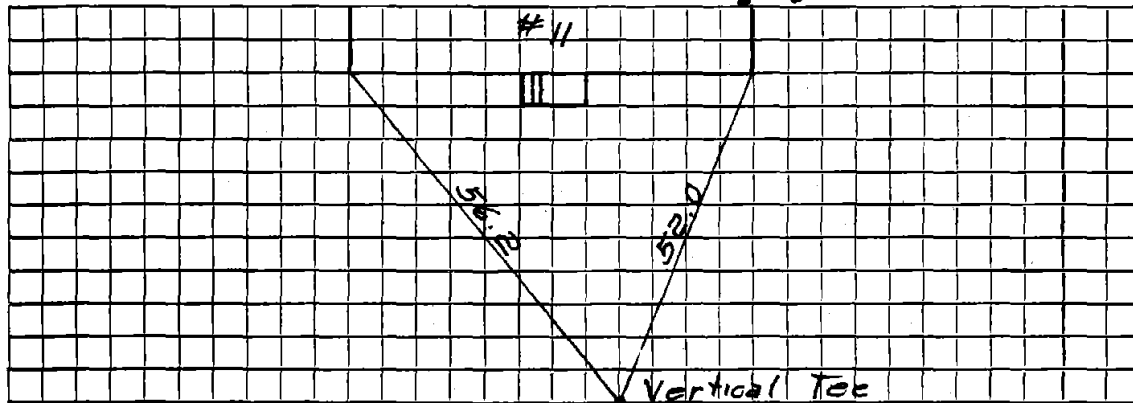

Connection made in..... Street.

Work completed.....19..

Remarks: