

Name **William L. Potter**

Service No. **49**

Address **15 Downing Rd.**

Location

Kind of Pipe

Size

Size of Main

~~Repair/Repair~~ — **New Service**

Location *Conn 75-0*

Date	Material	Amount	Total	Date	Amount
-16-60	Labor 63.48			<i>4-25-60</i>	<i>Deposit 200 00</i>
	10% O. H. 6.35		69 83	<i>7-5-60</i>	<i>Refund 30 14</i>
53'	6" Transite Pipe @ .78		41 34		<i>169 96</i>
1	6" Transite Elbow 90		5 29		
3	Hrs. Town Shovel @ 6.50		19 50		
2	Hrs. Trucking @ 3.00		6 00		
1	Hr. Trailer @ 3.00		3 00		
	25x3 Patch		25 00		
			169 96		


DATE _____

TOWN OF LEXINGTON — BOARD OF PUBLIC WORKS

SEWER DIVISION

Sketch of Service Here

15

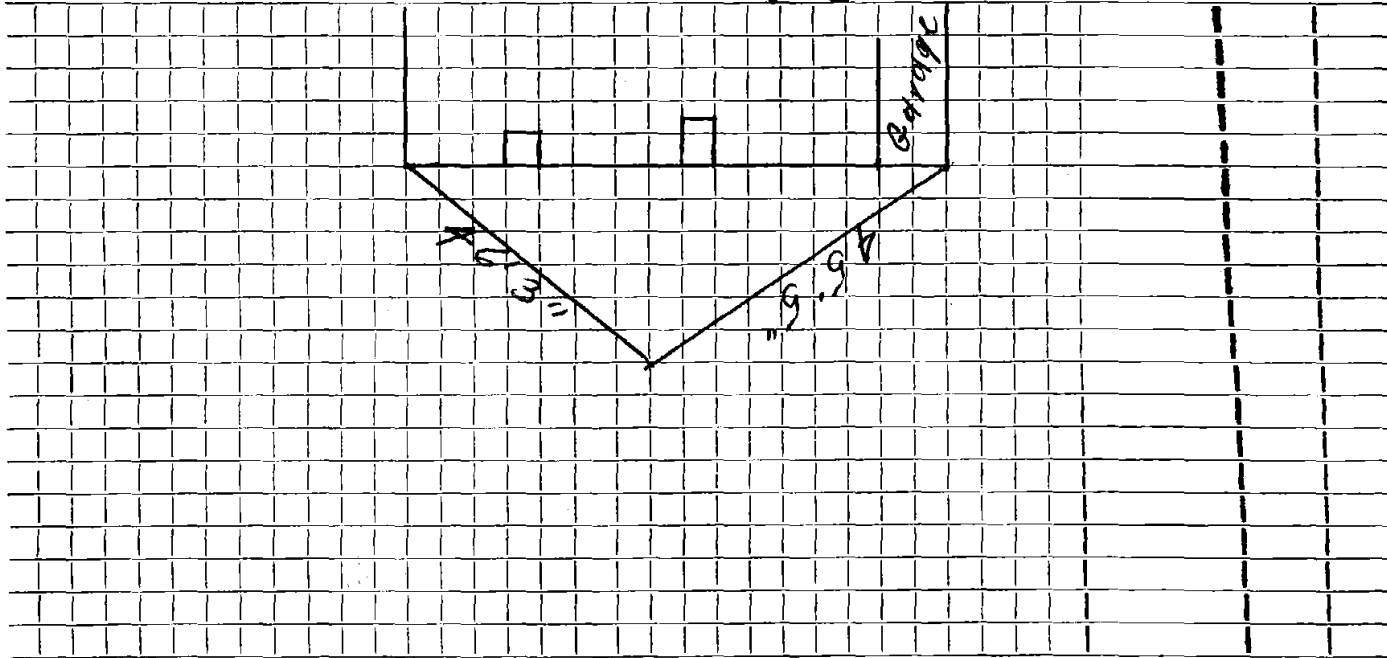

Connection made in Street. Work completed

Remarks: *46' 3" Could be 40' 3" Tie from Job. nat. ~~to~~ lead.*