

Name Michael Graziano

Service No. 78

Address 16 Downing Road

Location Comm. 10-29-56

Kind of Pipe

Size

Size of Main

~~Repair - Renewal~~ - New Service

Location

Date	Material	Amount	Total	Date		Amount
7/17/56	Labor	76.31		6-25-56	Deposit	# 20000
	10% overhead	7.63	83.94	11-15-56	Paid	33.72
	80' 6" Sewer pipe @ .455		36.40			233.72
	Joint Compound		1.80			
	10 x 3 Patching		10.00			
	11 1/3 Hrs. Littlefield @ 8.50		96.33			
	3 Hrs. trucking @ .75		2.25			
			233.72			
					Bill sent 11-5-56	
	Labor					

TOWN OF LEXINGTON—DEPT. OF PUBLIC WORKS
SEWER DIVISION

DATE

NO.


The undersigned applies for the construction of a particular sewer connecting No.
Street and hereby agrees to comply with the Rules and Regulations governing the construction and use of Particular
Sewers, as now or at any future time established by the Board of Selectmen.

Am't of estimate \$.....

Am't Paid \$.....

..... Owner

Sketch of Service Here

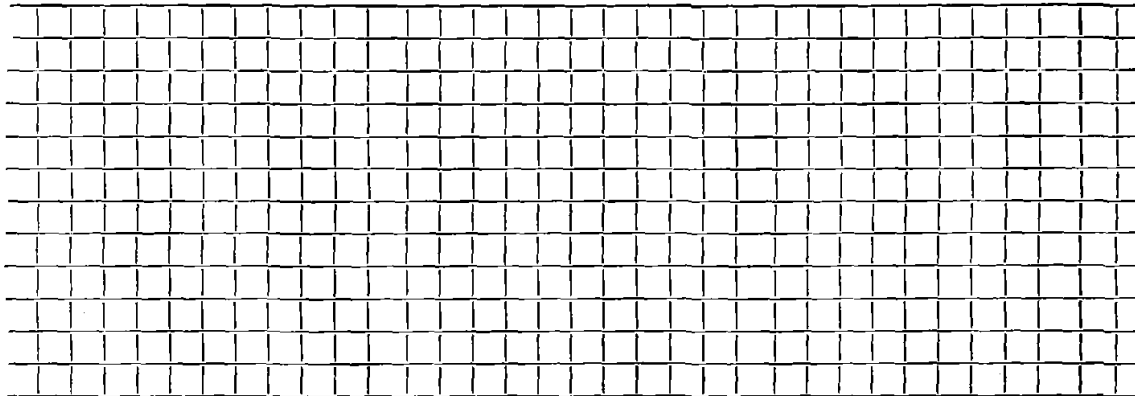

Connection made in Street.

Work completed 19..

Remarks: