

Name

Service No.

Address 19 Downing Road

Lot #22

Location

Kind of Pipe

Size

Size of Main

Repair—Renewal—**New Service**

Location

| Date | Material | Amount | Total | Date | Amount |
|---------|-------------------|--------|-------|-----------------|--------|
| 1-15-51 | 56' 6" Sewer Pipe | | | | |
| | | | | 7-9-70 | |
| | | | | 23' 6" Transite | |
| | | | | 1 8"X6" Saddle | |
| | | | | | |
| | | | | | |

DATE _____

TOWN OF LEXINGTON — BOARD OF PUBLIC WORKS

SEWER DIVISION

Sketch of Service Here

19

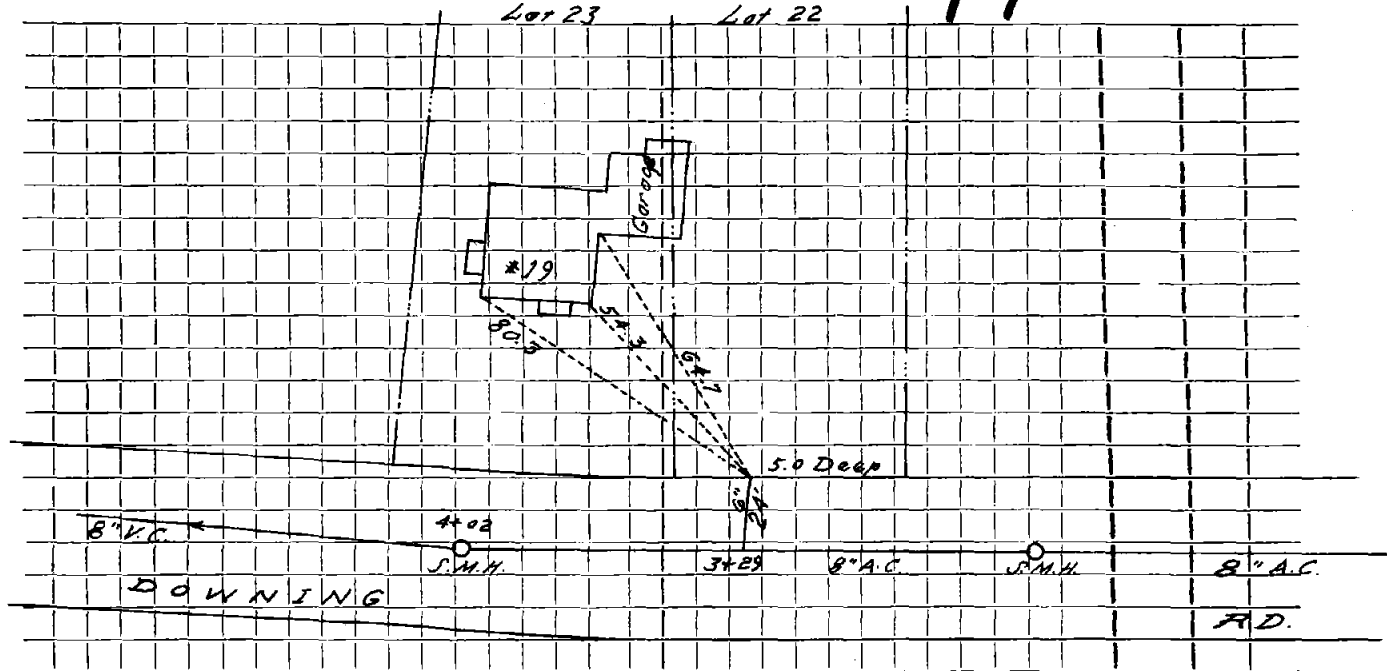

Connection made in Street. Work completed

Remarks:

.....

.....