

Name Preston Maxwell

Service No. 107

Address 22 Downing Road

Lexington

Location

Kind of Pipe

COM. 9-22-52

Size

Size of Main

~~Repair/Renewal~~ — New Service

Location

Date	Material	Amount	Total	Date	Amount
125/52	Labor	83 25		7-24-52 Deposited	125 00
	10% Overhead	8 33	91 58	9-22-52 Referred	
	52' - 6" sewer pipe @ .342		17 78	Credited to WAC # 203	178
	1 - 6" 1/8 bend @ 1.24		1 24		123 22
	joint compound		3 12		
	2 hrs. trucking		1 50		
	patching 8 X 3		8 00		
			123 22		
	Labor				

Name Preston Maxwell

Service No. 107

Address 22 Downing Road

Lexington

Location

Kind of Pipe

COM. 9-22-52

Size

Size of Main

~~Repair/Rehaul~~ — New Service

Location

Date	Material	Amount	Total	Date	Amount
8/25/52	Labor	83 25		7-24-52 Deposited	125 00
	10% Overhead	8 33	91 58	9-22-52 Rejected &	
	52' - 6" sewer pipe @ .342		17 78	credited to WNE #	1 78
	1 - 6" 1/8 bend @ 1.24		1 24		123 22
	joint compound		3 12		
	2 hrs. trucking		1 50		
	patching 8 X 3		8 00		
			123 22		
	Labor				

TOWN OF LEXINGTON—DEPT. OF PUBLIC WORKS
SEWER DIVISION

DATE.....

NO.


The undersigned applies for the construction of a particular sewer connecting No.....
Street and hereby agrees to comply with the Rules and Regulations governing the construction and use of Particular
Sewers, as now or at any future time established by the Board of Selectmen.

Am't of estimate \$.....

Am't Paid \$.....

..... Owner

Sketch of Service Here

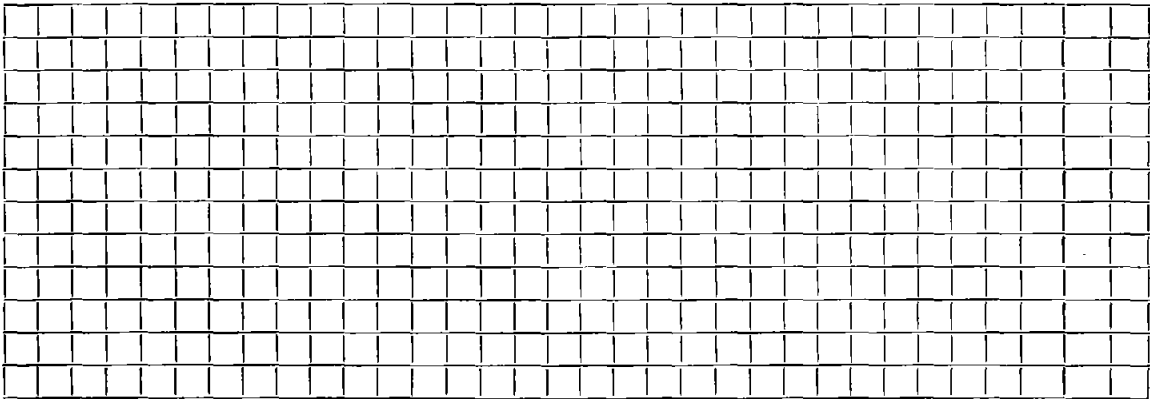

Connection made in..... Street.

Work completed..... 19..

Remarks: