


DATE APRIL 9 1998

TOWN OF LEXINGTON — BOARD OF PUBLIC WORKS

SEWER DIVISION

Sketch of Service Here

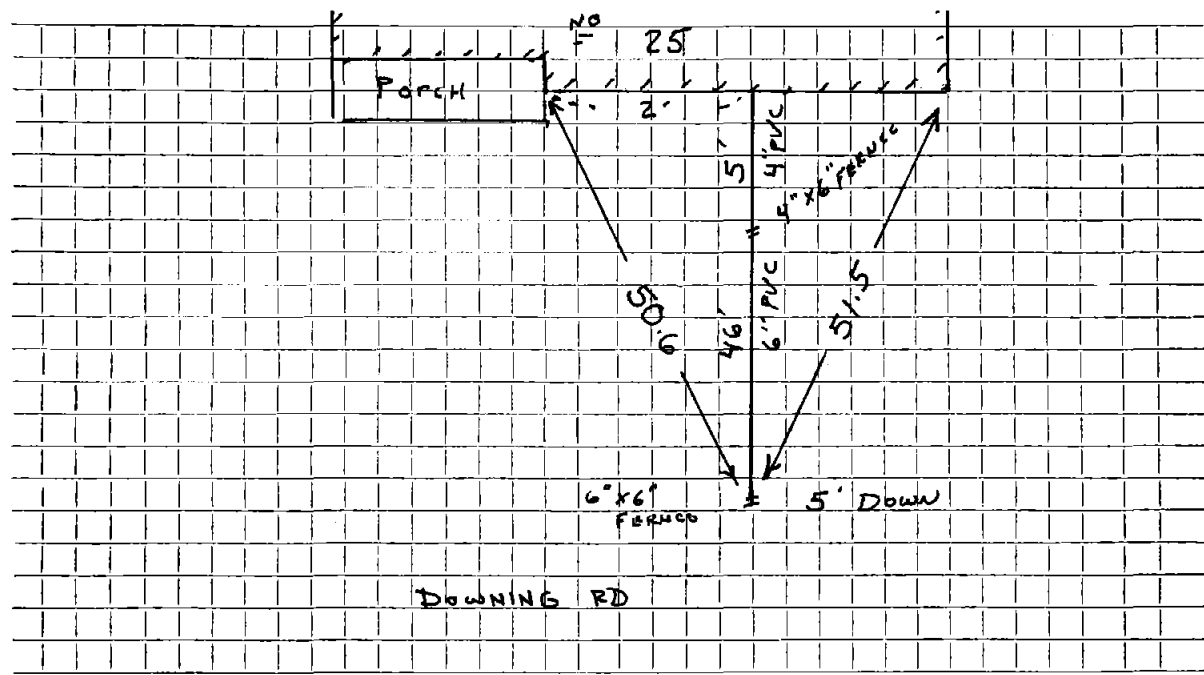

DOWNING RD

Connection made in DOWNING ROAD Street. Work completed SEAN TOCCI

Remarks:

FIELD BOOK 98-1

TJM

Name Frank T. Preston

Service No. 151 (1954)

Address 25 DOWNING ROAD

Location

Kind of Pipe

Size

Size of Main

~~Repair~~ ~~Renewal~~ ~~New Service~~ COM.1-31-55

Location

Date	Material	Amount	Total	Date	Amount
1/3/55	Labor	26 77		10-26-54	Deposited 175 00
	10% overhead	2 68	29 45	1-31-55	Refunded (82 69)
	46' - 6" sewer pipe @ .32		14 72		92 31
	1 - 6" elbow		1 88		
	joint compound		2 76		
	5 hrs. Littlefield shovel @ 7.50		37 50		
	2 hrs. trucking @ 3.00		6 00		
			92 31		
	Labor				

