

Name Ted Freeman; 23 Washington Drive; Acton

Service No. 111

Address 27 Downing Road

Location

Kind of Pipe

Size

Size of Main

~~Repair~~ ~~Renewal~~ ~~Service~~ ~~W.O. #2701~~

*Eagle # 2595*

Location FEB 10 1975

Date	Material	Amount	Total	Date	Amount
11-13-74	Labor	66.43		11-1-74	300.00
11-18-74	"	<u>17.59</u>	84.02	2-10-75	38.36
	10% O.H.	8.40	\$ 92.42		241.74
	20' 6" Transite Pipe	@1.24	24.80		
	1 6" Cap		2.89		
	1/2 Bag Cement		.55		
	1 1/2 Ton Cold Patch	@12.20	18.30		
	2 Hrs. Trucking	@3.00	6.00		
	2 Hrs. Pick up	@1.50	3.00		
	1 Hr. Town Shovel		6.50		
	1 Hr. Loader		4.00		
	2 Hrs. Compressor	@5.00	10.00		
	Patch 24' x 4'		93.28		
			<u>\$261.74</u>		


DATE \_\_\_\_\_

TOWN OF LEXINGTON — BOARD OF PUBLIC WORKS

SEWER DIVISION

Sketch of Service Here

27

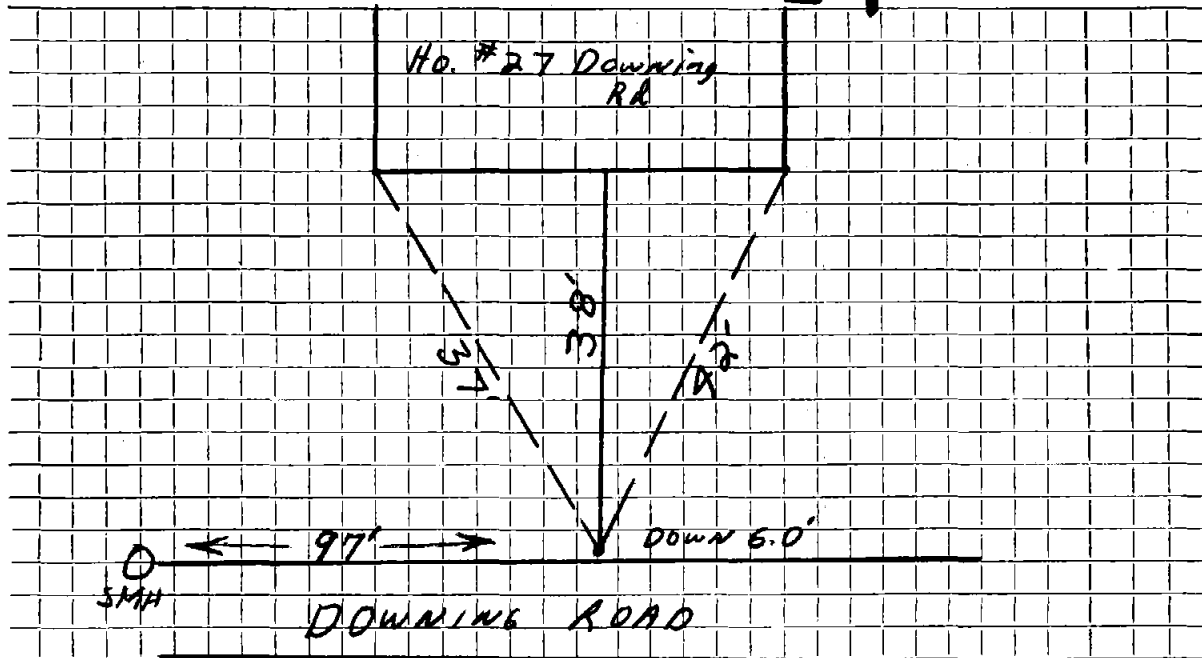

Connection made in DOWNING ROAD Street. Work completed .....

Remarks: .....  
.....  
.....