

Name Robert W. Adamson

Service No. 103

Address 3 Downing Road

Location

Kind of Pipe

Size

Size of Main

~~Repair Renewal~~ New Service W.O. #7450

Location Comm 10-29-62


Date	Material	Amount	Total	Date	Amount
7/23/62	Labor	93 20		7-6-62	Deposit 250 00
	10% O.H.	9 32		10-29-62	ReFund 22 87
			102 52		227 16
	52' 6" Transite Pipe @ .82		42 64		
	4 hrs. Town Shovel @ 6.50		26 00		
	2 hrs. trucking @ 3.00		6 00		
	50 x 3 patch		50 00		
			227 16		

DATE \_\_\_\_\_

TOWN OF LEXINGTON — BOARD OF PUBLIC WORKS

**SEWER DIVISION**

Sketch of Service Here

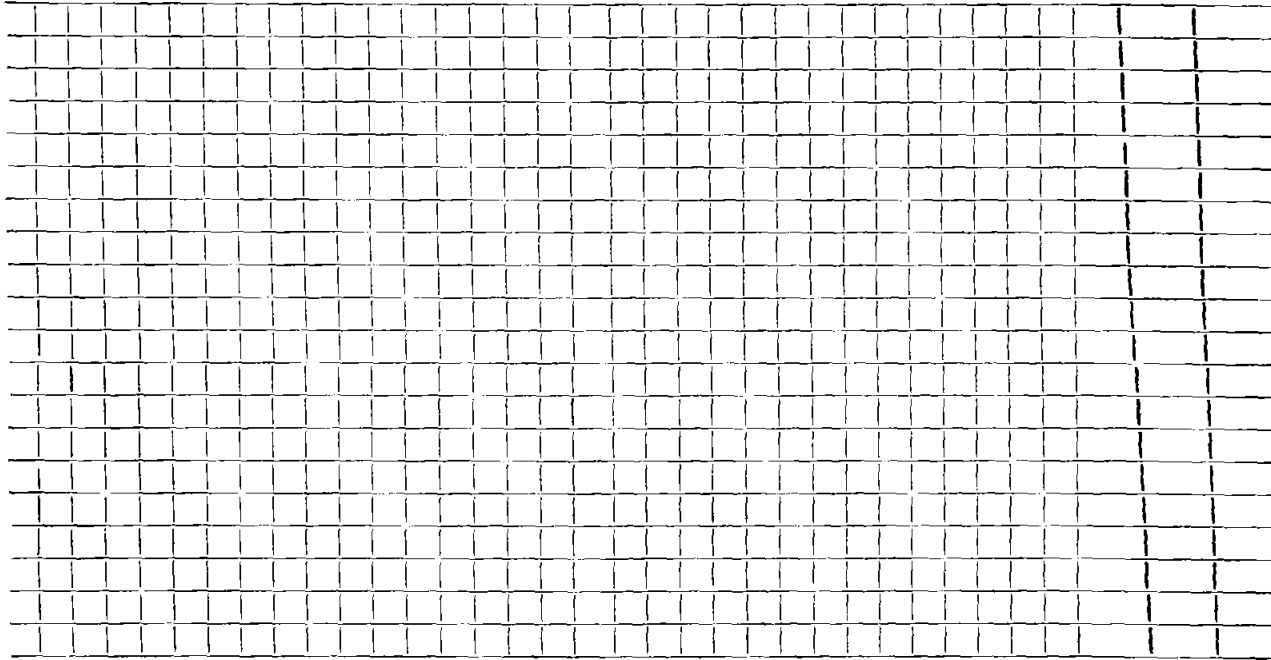

Connection made in ..... Street.                      Work completed .....

Remarks: .....

.....

.....