

Name Joseph Brucci
 Address 32 Downing Road

Service No. 95

Location

Kind of Pipe

Size

Size of Main

~~Repair/Replacement~~ **New Service**

COM. 7-19-54

Location

Date	Material	Amount	Total	Date	Amount
6/23/54	Labor	13 93		6-17-54 Deposited	75 00
	10% overhead	1 39	15 32	7-20-54 Re-funded	(9 12)
	46' - 6" sewer pipe @ .30		13 80		65 88
	joint compound		2 76		
	3 hrs. Littlefield shovel @ 7.50		22 50		
	2 hrs. trucking @ .75		1 50		
	patching 10 x 3		10 00		
6-22-64	Renewal		65 88		
	43' 6" Transite				
	1 6" - 1 1/4" Bend			6-5-64	28 32
	1 6" - 2 1/2" Bend				
	Labor			6-5-64	
				4-11-65	
				5-5	
					PAPER
					PLUGGED TOWN Problem 64' out
					5-15-90 - Roots + Solids
					12-24-87 - Roots
					11-3-84 - Roots 250' up

TOWN OF LEXINGTON—DEPT. OF PUBLIC WORKS
SEWER DIVISION

DATE.....

NO.....


The undersigned applies for the construction of a particular sewer connecting No.....
 Street and hereby agrees to comply with the Rules and Regulations governing the construction **and** use of Particular
 Sewers, as now or at any future time established by the Board of Selectmen.

Am't of estimate \$.....

Am't Paid \$.....

..... Owner

Sketch of Service Here **32**

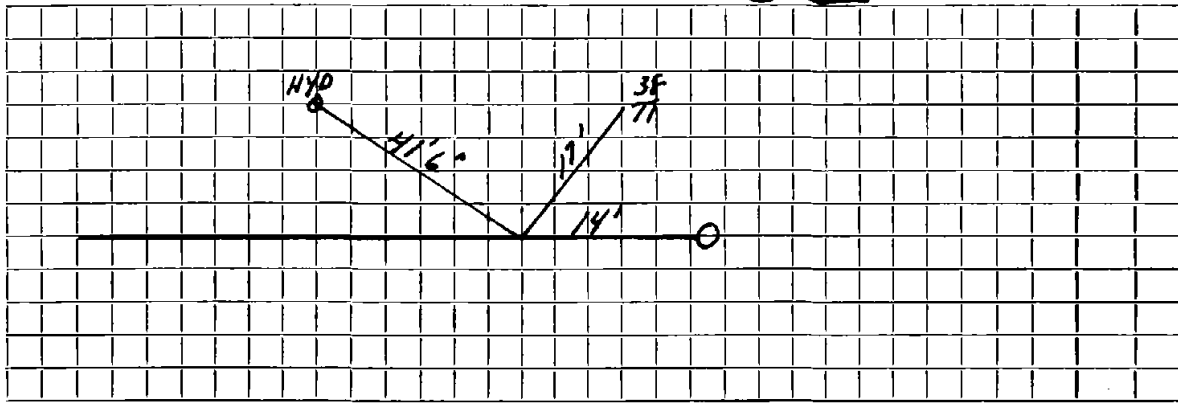

Connection made in..... Street.

Work completed.....19..

Remarks: