

Name Jeff Arbetter

Service No.

Address 35 Downing Rd. - Lot #28

Location

Kind of Pipe

Size

Size of Main

Repair—Renewal—New Service install service main to curb - W.O. #7871

Location


Date	Material	Amount	Total	Date	Amount
/10/70	Labor	155.28			
	10% O.H.	<u>15.53</u>	170.81		
25'	6" Transite @ .90		22.50		
1	bag Cement		1.55		
30	Brick @ .07		2.10		
2	hrs. Trucking @ 3.00		6.00		
2	hrs. Loader @ 5.00		10.00		
3	hrs. Shovel @ 6.50		<u>19.50</u>		
			\$ 232.46		
/15/81	20' 6" Transite				
	Renewed by D. & L. #3682			4/28/72	Roots 6-10' Out
				5-30-75	Roots 10' Out

DATE Oct. 15, 1981

TOWN OF LEXINGTON — BOARD OF PUBLIC WORKS
SEWER DIVISION

Sketch of Service Here

35

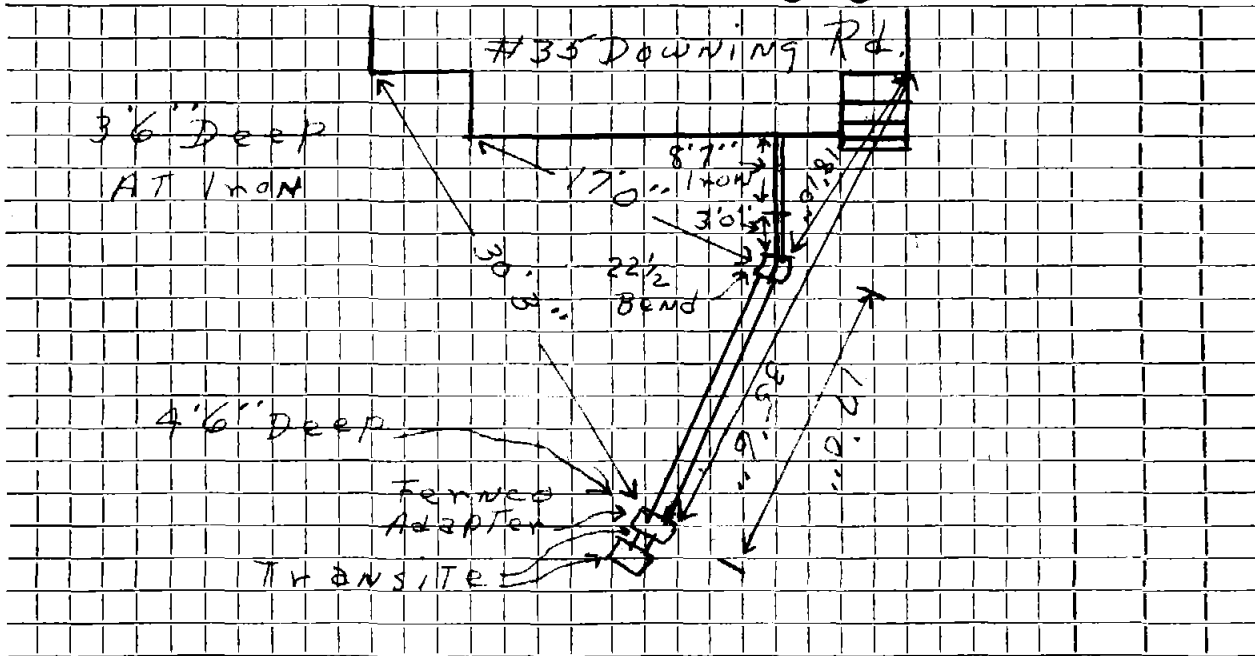

Connection made in Street. Work completed

Remarks:

.....

.....

Name

Service No.

Address 35 Downing Road

Ept #28

Location

Kind of Pipe

Size

Size of Main

Repair—Renewal—**New Service**

Location

Date

Material

Amount

Total

Date


Amount

DATE _____

TOWN OF LEXINGTON — BOARD OF PUBLIC WORKS

SEWER DIVISION

Sketch of Service Here

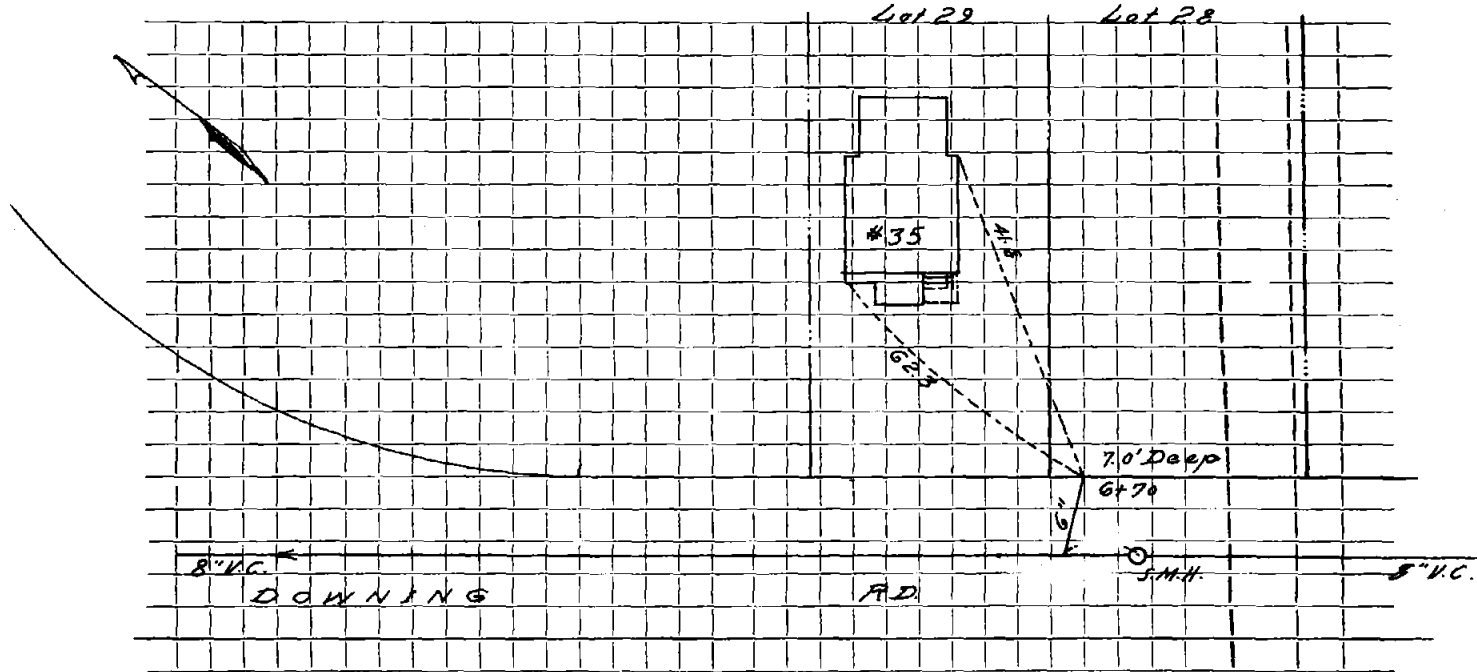

Connection made in Street. Work completed

Remarks:

.....
.....