

Name **Eric E. Hagman**Service No. **45**Address **39 Downing Road****Lexington**

Location

Kind of Pipe

Size

#2502

Size of Main

~~REPAIR WORK~~ **New Service**

COM. 4-27-53

**Renewal,
Lexington Sewerage**

Location

Date	Material	Amount	Total	Date	Amount
4/2/53	Labor	38 00		3-24-53	Deposited 125 -
	10% overhead	3 80	41 80	4-27-53	Refunded (4 57)
	55' -5" transite pipe @ .55		30 25		120 43
	1 - 6" elbow		1 88		
	4 hrs. littlefield shovel @ 7.50		30 00		
	2 hrs. trucking @ .75		1 50		
	patching 15 x 3		15 00		
			<u>120 43</u>		
5-21-74	35' 5" Transite pipe.				
	10' 4" Cast Iron pipe				
6-20-86	Repair				
	31' tubes 6" P.V.C.				
	1 6" - 30° Sweep			5-21-74	Plugged Sewer Service
	1 6" - 6" Wye Cleanout			4-21-60	RESPONSE Root in Road
	1 6" X 6" Fernco				
	1 6" X 4" Fernco				

**TOWN OF LEXINGTON—DEPT. OF PUBLIC WORKS
SEWER DIVISION**

DATE.....

NO.....

The undersigned applies for the construction of a particular sewer connecting No.....
Street and hereby agrees to comply with the Rules and Regulations governing the construction and use of Particular
Sewers, as now or at any future time established by the Board of Selectmen.


Am't of estimate \$.....

Am't Paid \$.....

..... Owner

Sketch of Service Here

39

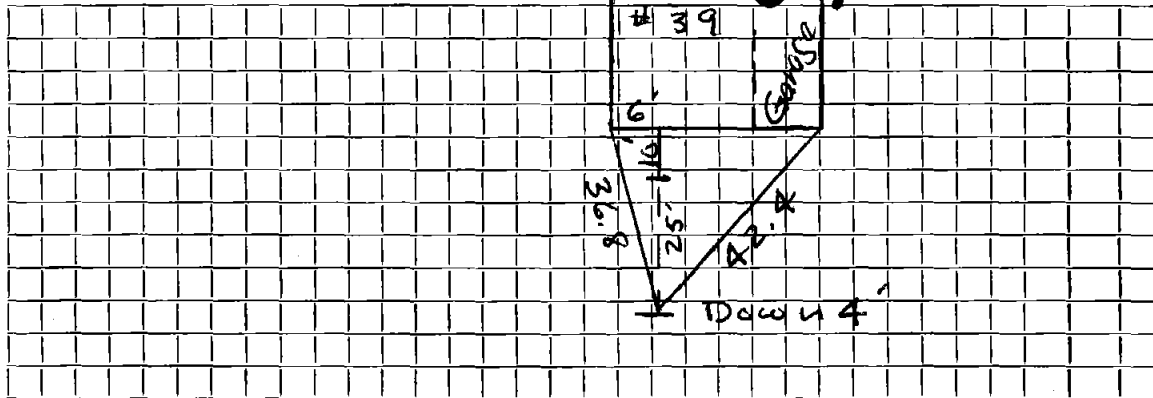

Renewal
Lex. Sewerage
Permit #2502

Connection made in..... Street.

Work completed.....19..

Remarks: