

Name Ted Freeman

Service No. 28

Address

44 Downing Rd. - Lot #184

Location

Kind of Pipe

Size

Size of Main

Repair—Renewal—**New Service**

install service main to curb - W.O. #7873
Eagle #2489

Location

AUG 16 1976

| Date | Material | Amount | Total | Date | Amount |
|--------|-----------------------------|--------|-----------|---------|--------|
| 8/8/70 | Labor | 115.62 | | 5/22/74 | 224.57 |
| 7/70 | " | 38.52 | | | |
| | | 154.14 | | | |
| | 10% O.H. | 15.41 | 169.55 | | |
| | 10' 6" 2400 Transite @ 1.02 | | 10.20 | | |
| | 30' 6" 1500 Transite @ .96 | | 28.80 | | |
| | 1 6" Cap | | 1.63 | | |
| | 1/2 bag Cement @ 1.55 | | .39 | | |
| | 3 hrs. Truck @ 3.00 | | 9.00 | | |
| | 1 hr. Loader | | 5.00 | | |
| | | | \$ 224.57 | | |
| 15/74 | 20' 6" Transite Pipe | | | | |
| | 10' 4" Cast Iron Pipe | | | | |


DATE _____

TOWN OF LEXINGTON — BOARD OF PUBLIC WORKS

SEWER DIVISION

Sketch of Service Here

44

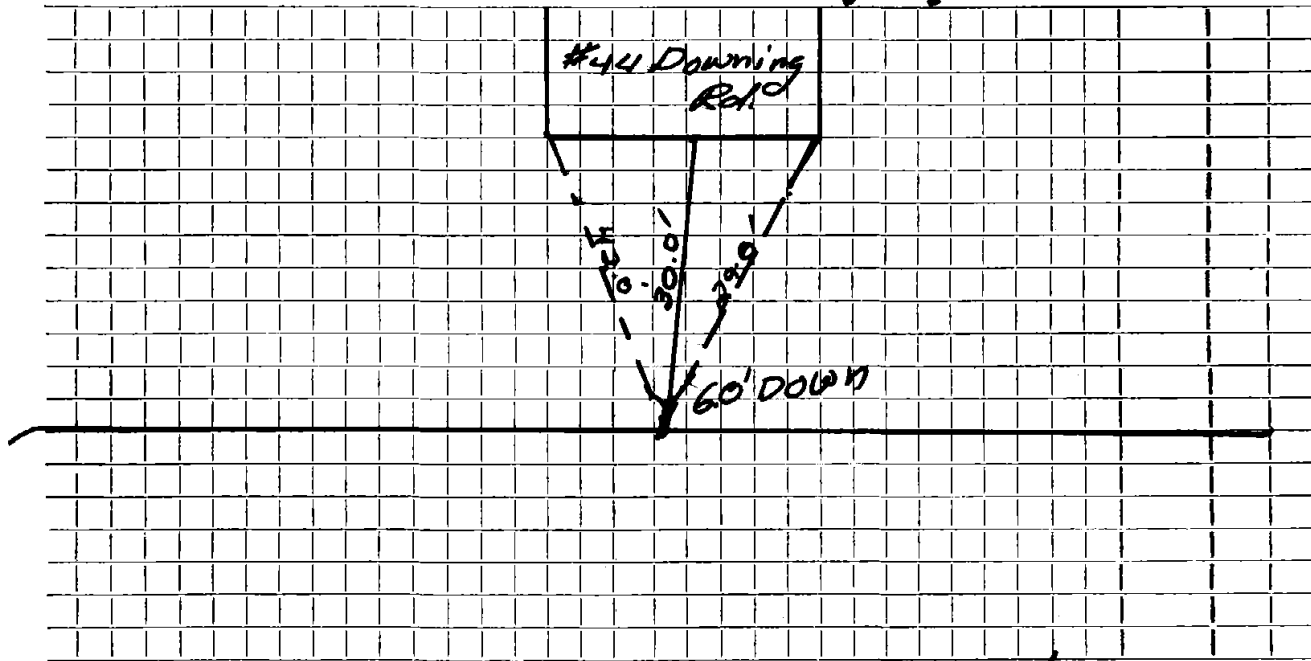

Connection made in Downing Rd. Street.

Work completed 6/5/74

Remarks: