

Name **Harvey B. Adams**

Service No. **171**

Address **46 Downing Road
Lexington, Mass.**

Location

Kind of Pipe

Size

Size of Main

~~Repair~~ ~~Renewal~~ **New Service**

Com 12-3-51

Location

Date	Material	Amount.	Total	Date	Amount
10/31/51	Labor	57 37	57 37	10-25-51	Deposited 250 00
	10% overhead		5 74	12-23-51	Pro-vided (29 29)
	50' - 6" sewer pipe @ .342		17 10		120 71
	joint compound		3 00		
	4 hrs. Brox Shovel @ 9.00		36 00		
	2 hrs. trucking @ .75		1 50		
			120 71		

Labor

TOWN OF LEXINGTON—DEPT. OF PUBLIC WORKS
SEWER DIVISION

DATE

NO.


The undersigned applies for the construction of a particular sewer connecting No.
Street and hereby agrees to comply with the Rules and Regulations governing the construction **and use of Particular**
Sewers, as now or at any future time established by the Board of Selectmen.

Am't of estimate \$.

Am't Paid \$.

..... Owner

Sketch of Service Here

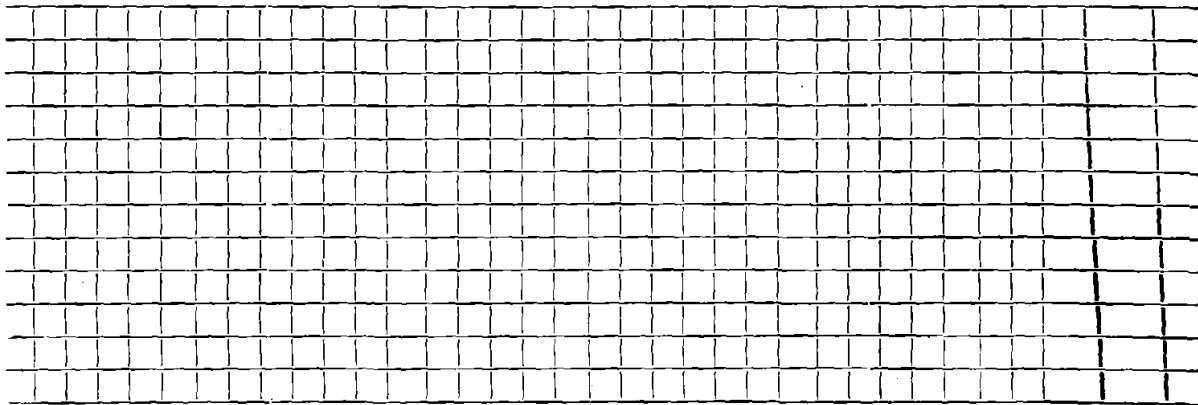

Connection made in Street.

Work completed 19..

Remarks: