

Name **George Beckonert**

Service No. **128**

Address **47 Downing Road**

Location

Kind of Pipe

Size

Size of Main

~~Service Known~~ **New Service**

Location *Comm 11-9-59*


Date	Material	Amount	Total	Date	Amount
9-59	Labor	77.47		9-11-59	200.00
	10% O.H.	7.75	85.22	11-9-59	18.58
	67' 6" Transite pipe @.70		46.90		181.12
	3 hrs. Town Shovel @ 6.50		19.50		
	2 hrs. Trucking @.75		1.50		
	28 X 3 Patch		28.00		
			181.12		

DATE _____

TOWN OF LEXINGTON — BOARD OF PUBLIC WORKS

SEWER DIVISION

Sketch of Service Here

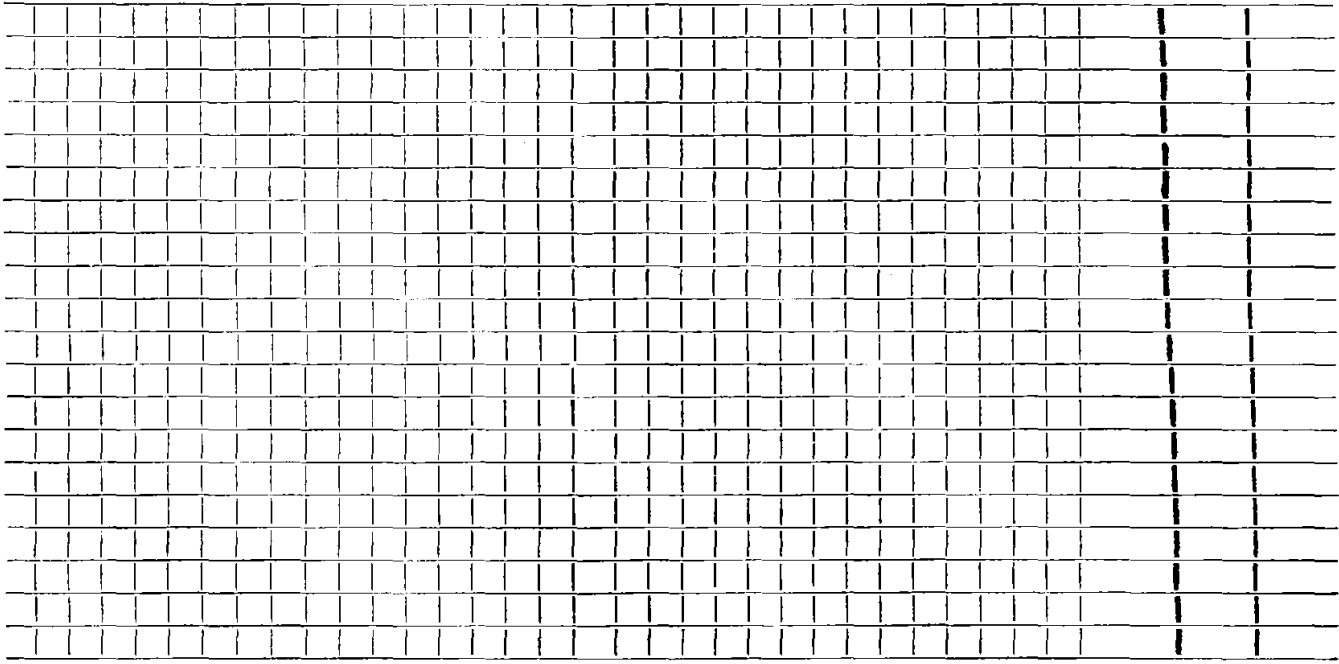

Connection made in Street. Work completed

Remarks:
.....
.....