

Name Andrew Deveau

Service No. 189

Address 49 Downing Road

Lexington, Mass.

Location

Kind of Pipe

Size

Size of Main

~~Repair~~ ~~Renewal~~ — New Service

com. 12-31-51

Location

Date	Material	Amount	Total	Date	Amount
11/16/51	Labor	65 54	65 54	11-13-51	Deposited 125 00
	10% overhead		6 55	11-31-51	Refunded (12 29)
	60' - 6" sewer pipe @ .342		20 52		112 71
	joint compound		3 60		
	3 hrs. Town shovel @ 5.00		15 00		
	2 hrs. trucking		1 60		
11-12-59	Repair		112 71		
	4' 6" Transite				
	Labor				

TOWN OF LEXINGTON—DEPT. OF PUBLIC WORKS

SEWER DIVISION

DATE

NO.


The undersigned applies for the construction of a particular sewer connecting No.
Street and hereby agrees to comply with the Rules and Regulations governing the construction and use of Particular
Sewers, as now or at any future time established by the Board of Selectmen.

Am't of estimate \$.....

Am't Paid \$.....

..... Owner

Sketch of Service Here

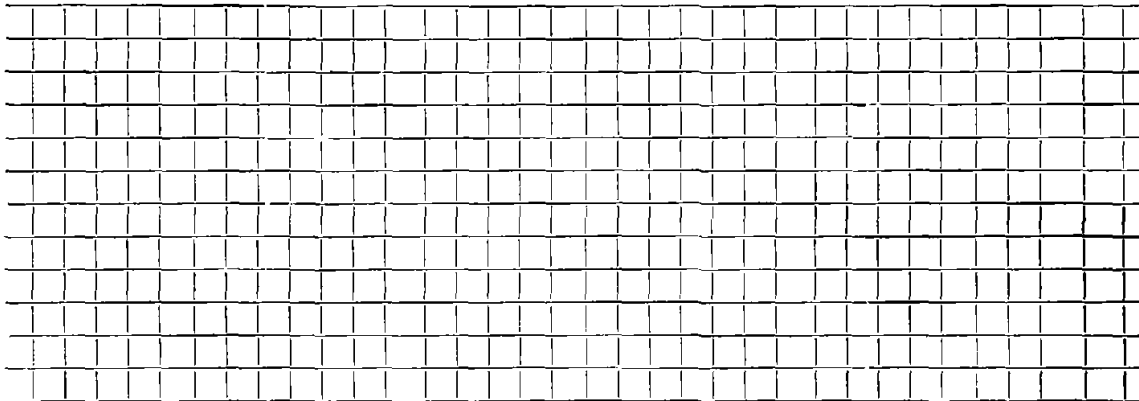

Connection made in Street.

Work completed 19..

Remarks: