

Name**Service No.****Address** 5 Downing Road

Lot #19

Location**Kind of Pipe****Size****Size of Main****Repair—Renewal—New Service****Location**

Date	Material	Amount	Total	Date	Amount
- 5 - 61			176 27		
	58' 6" Transite				
	12' 6" C.I. Pipe				
	2 6"-1/4° Elbow			7-7-70	
	1 6"-90° Elbow			25' 6" Transite	


DATE _____

TOWN OF LEXINGTON — BOARD OF PUBLIC WORKS

SEWER DIVISION

Sketch of Service Here

5

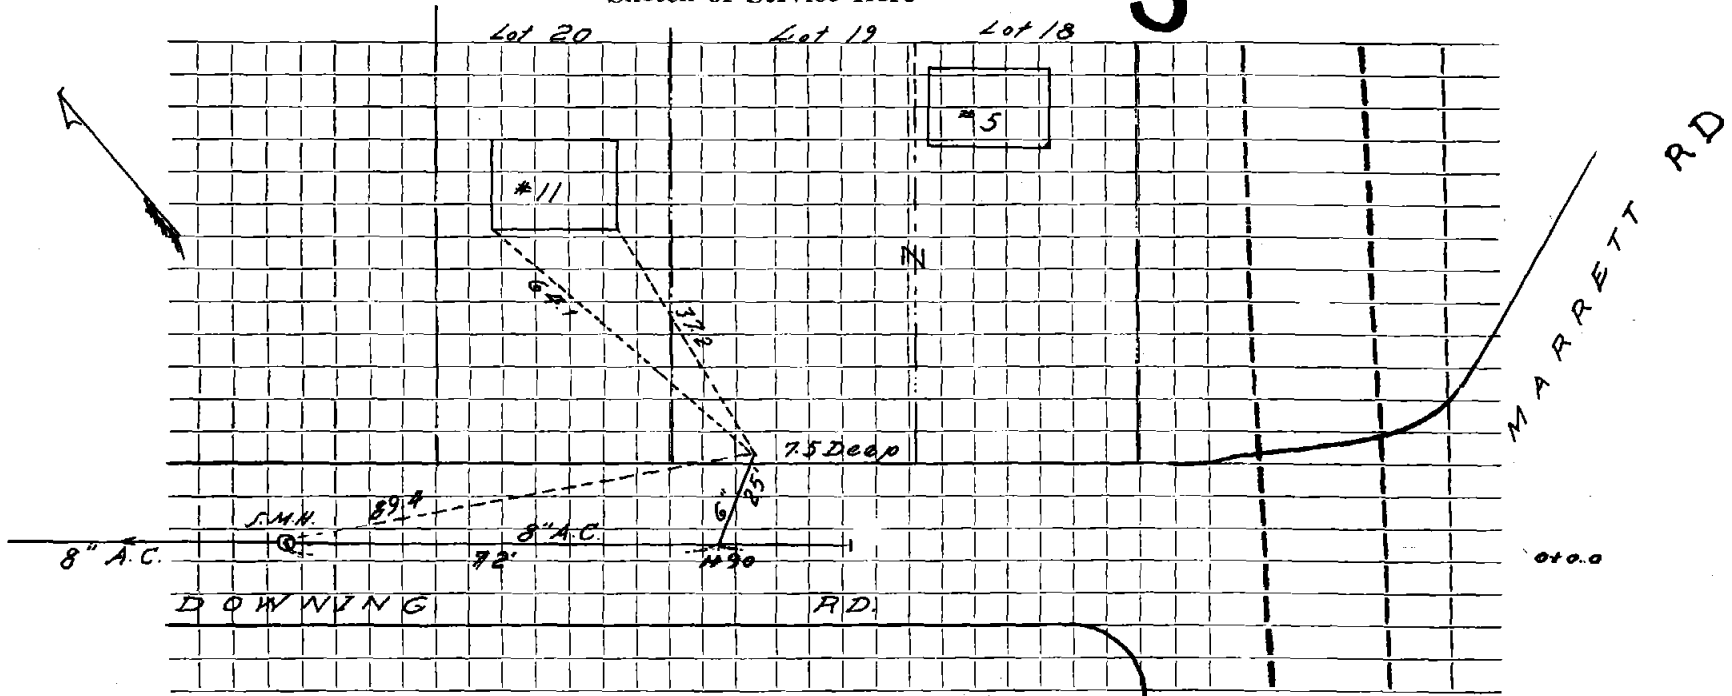

Connection made in Street. Work completed

Remarks:

.....

.....