




DATE \_\_\_\_\_

**TOWN OF LEXINGTON — BOARD OF PUBLIC WORKS**  
**SEWER DIVISION**

Sketch of Service Here

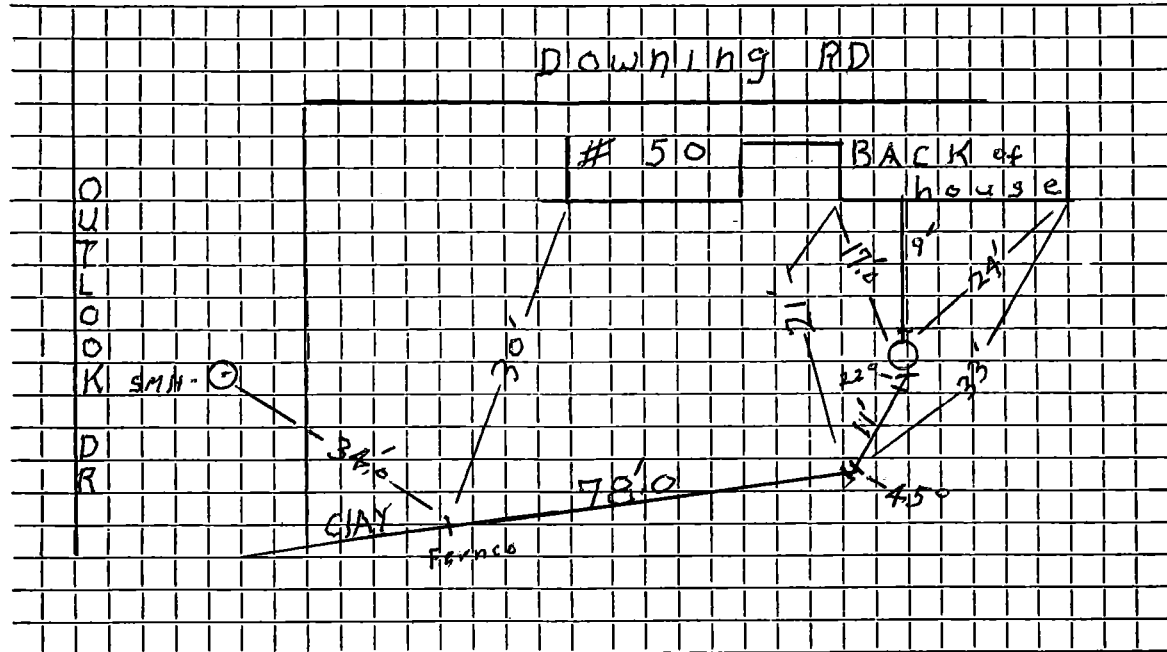

Connection made in OUTLOOK D.R. Street. Work completed 12/9/10 Drum Hill Conf.

Remarks: # No 50 Downing RD

.....

.....