

Name Robert J. McElligott

Service No. 205

Address 53 Downing Road

Location Lexington, Mass.

Location

Kind of Pipe

Size

Size of Main

Repair ~~Renewal~~ — New Service

COM. 2-11-52

Location

Date	Material	Amount	Total	Date	Amount
1/28/52	Labor	64 56		12-7-51	150 00
1/31/52	"	24 27	88 83	2-11-52	(9 18)
	10% overhead		8 88		140 82
	64' - 6" sewer pipe @ .342		21 89		
	1 - 6" elbow		1 88		
	joint compound		3 84		
	4 hrs. Jaeger pump @ 1.00		4 00		
	2 hrs. tow shovel @ 5.00		10 00		
	2 hrs. trucking @ .75		1 50		
			140 82		
	<b>Labor</b>			2-20-66	PAID + SOLIDS

**TOWN OF LEXINGTON—DEPT. OF PUBLIC WORKS**  
**SEWER DIVISION**

DATE .....

NO. ....


The undersigned applies for the construction of a particular sewer connecting No. ....  
Street and hereby agrees to comply with the Rules and Regulations governing the construction **and use of Particular**  
Sewers, as now or at any future time established by the Board of Selectmen.

Am't of estimate \$.....

Am't Paid \$.....

..... Owner

**Sketch of Service Here**

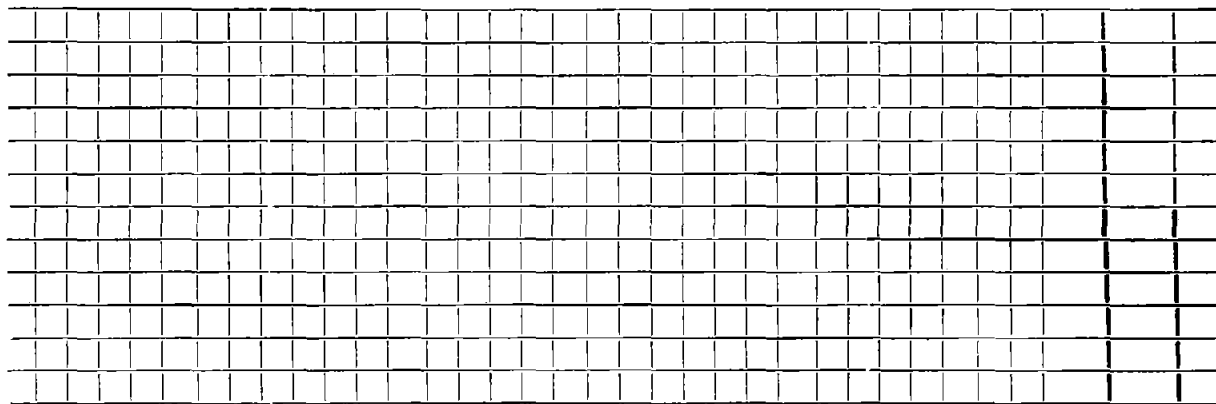


Connection made in ..... Street.

Work completed .. . . . . 19..

Remarks: