

Name Donna Realty Trust

Service No. 52

Address 15 Drew Avenue

Lots 59+60 Sta.2+30 Right

Location

Kind of Pipe

Size

Size of Main

Repair—Renewal—**New Service**

Location **SEP 21 1970**


Date	Material	Amount	Total	Date	Amount
-26-63	Labor	115.26		6-29-70	185.00
	10% O.H.	11.53	126.79	9-31-70	13.64
17'	6" Transite pipe @.32		13.94		171.36
1	90° Transite Elbow		4.09		
1	6" Nipple		1.04		
3	hrs. Town Shovel @6.50		19.50		
2	hrs. Trucking @3.00		6.00		
	BILL WHEN CONNECTED		171.36		
23/70	70' 6" Transite pipe				

DATE _____

TOWN OF LEXINGTON — BOARD OF PUBLIC WORKS
SEWER DIVISION

Sketch of Service Here

15

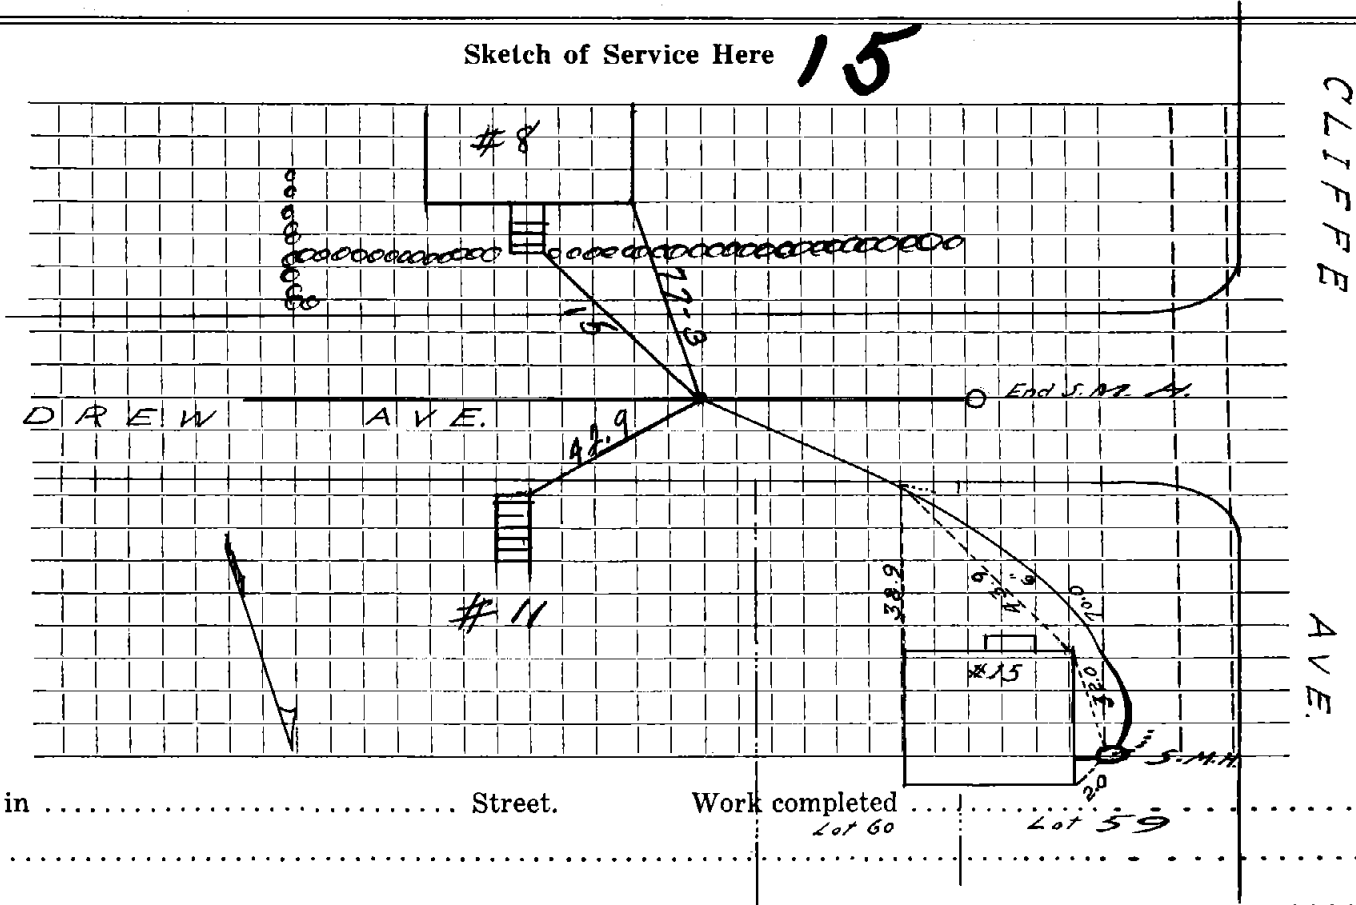

Connection made in Street.

Work completed

Lot 60

Lot 59

Remarks:
.....
.....