

Name **Duffy Bros.**

Service No.

Address 15 Dudley Road

Lot #227

Location

Kind of Pipe

Size

Size of Main

Repair—Renewal—**New Service** Bonanno #1398 & 1411

Location


Date		Material	Amount		Total		Date		Amount	
7-15-69	58'	6" Transite pipe								
	10'	4" Cast Iron pipe								

DATE _____

TOWN OF LEXINGTON — BOARD OF PUBLIC WORKS

SEWER DIVISION

Sketch of Service Here **15**

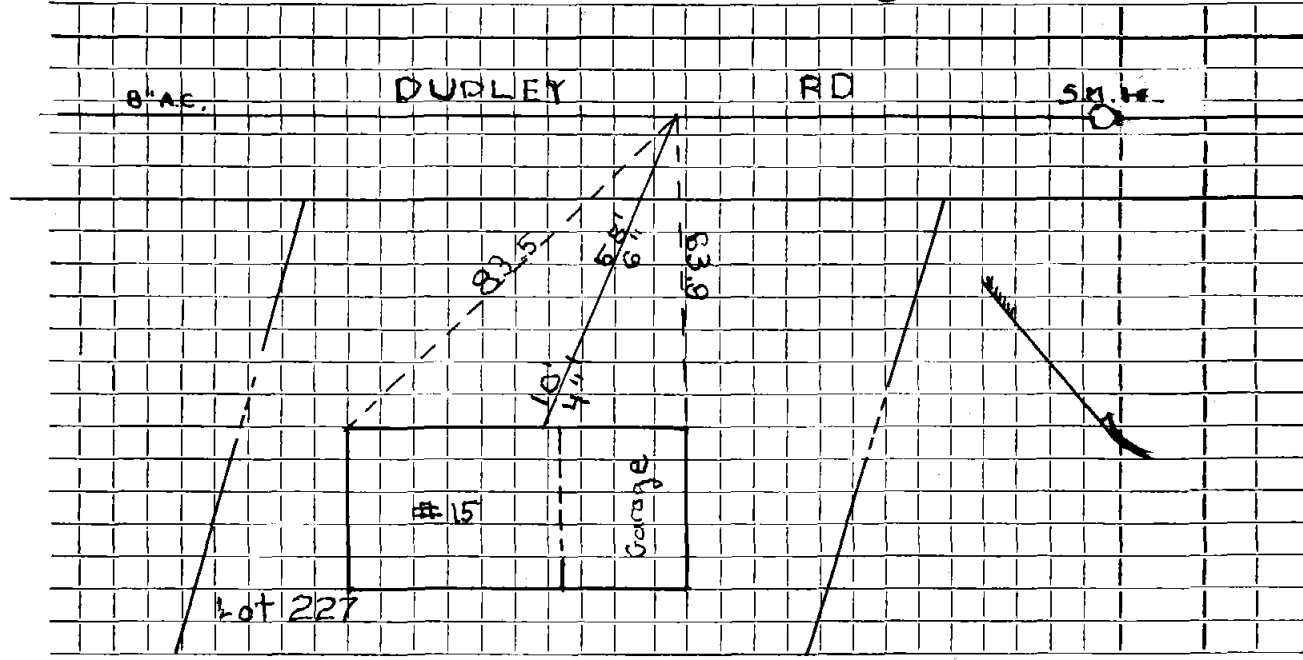

Connection made in Street. Work completed

Remarks:
.....
.....