




SEWER DIVISION

Sketch of Service Here  
**17**

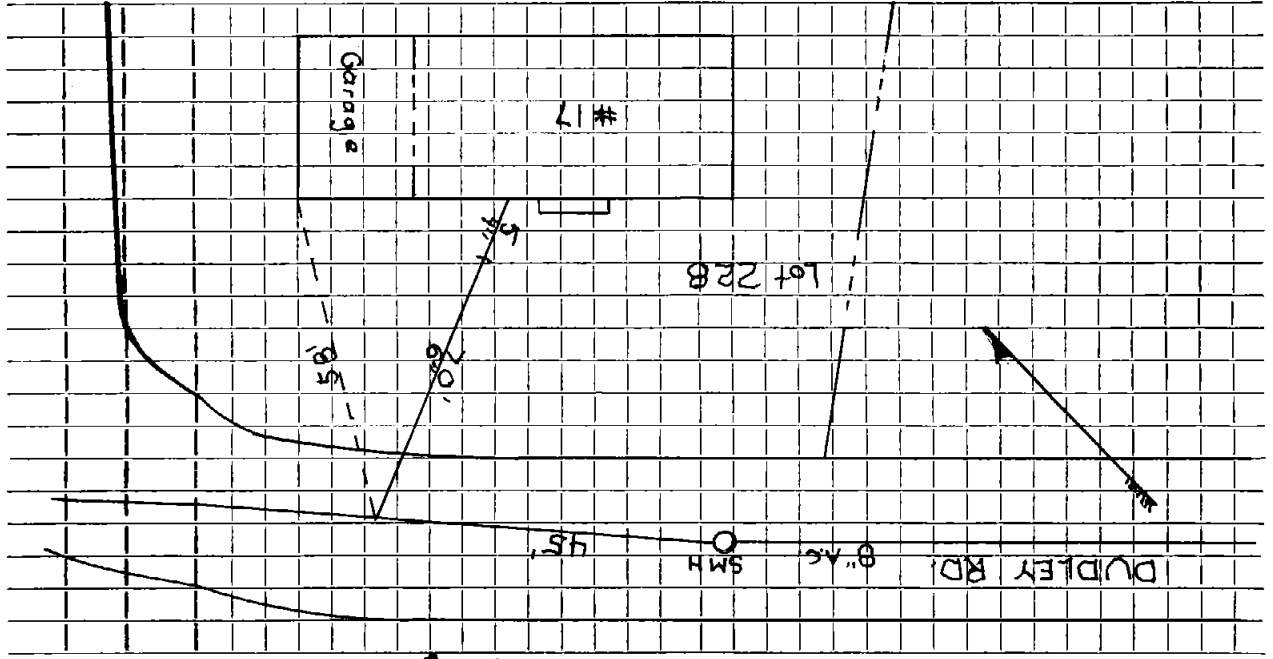

Connection made in \_\_\_\_\_ Street.

Work completed \_\_\_\_\_

Remarks: \_\_\_\_\_