

Name Anthony DiRocco

Service No. 204 ND

Address 12 Dunham Road

W.O. #9195

Location

Kind of Pipe

Size

Size of Main

~~Repair~~ ~~Renew~~ **New Service**

Location DEC 28 1964


Date	Material	Amount	Total	Date	Amount
0-9-64	Labor	59 21		5-14-65	108 14
	10% O.H.	5 92	65 13		
	18"6" Transite pipe @.82		14 76		
	1 Sewer Saddle		5 25		
	2 Hrs. Town Shovel @6.50		13 00		
	2 Hrs. Trucking @3.00		6 00		
	1 Hr. Loader @4.00		4 00		
			<u>108 14</u>		
				2-18-68 Paper	

DATE \_\_\_\_\_

TOWN OF LEXINGTON — BOARD OF PUBLIC WORKS

SEWER DIVISION

Sketch of Service Here

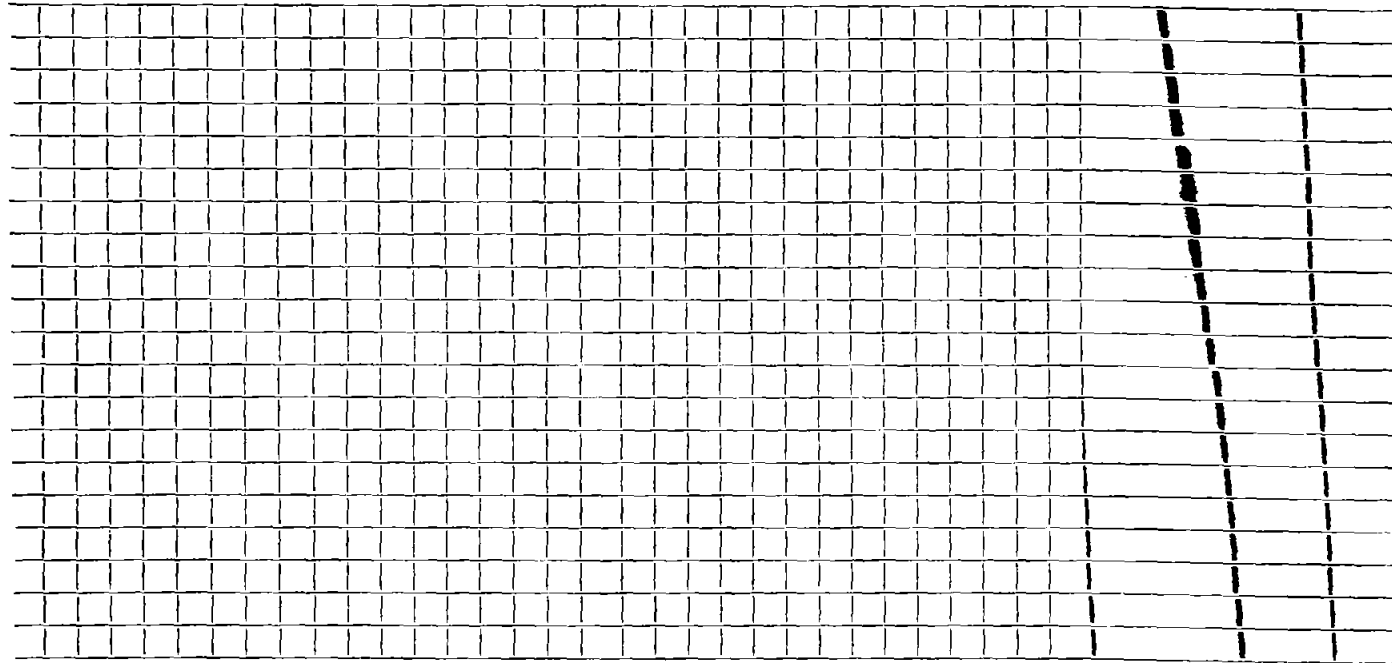

Connection made in ..... Street.      Work completed ..... - - - - -

Remarks: .....  
.....  
.....