

Name Lena Bacigalupo

Service No. 67

Address 7 Dunham Road

Location

Kind of Pipe

Size

Size of Main

~~Repair - Renewal~~ - New Service

Location *Comm 11-10-58*

Date	Material	Amount	Total	Date		Amount
5-9-58	Labor	65.08		<i>5-1-58</i>	<i>Deposit</i>	<i>175.00</i>
	10% O.H.	6.51	71.59	<i>11-11-58</i>	<i>Retrad</i>	<i>42.10</i>
	62' 6" Transite pipe @.70		43.40			<i>132.84</i>
	3' 6" Clay pipe @.435		1.31			
	1 6" 1/8 Clay Bend		1.24			
	1 6 x 6 Clay Y		1.16			
	1 11 1/4° Transite Bend		5.10			
	1 11 1/4° Transite Elbow		2.24			
	8 ton Bank Gravel @.85 ton		6.80			
			132.84			
	Labor					

**TOWN OF LEXINGTON—DEPT. OF PUBLIC WORKS
SEWER DIVISION**

DATE.....

NO.

The undersigned applies for the construction of a particular sewer connecting No.....
Street and hereby agrees to comply with the Rules and Regulations governing the construction and use of Particular
Sewers, as now or at any future time established by the Board of Selectmen.


Am't of estimate \$.....

Am't Paid \$.....

..... Owner

Sketch of Service Here

7

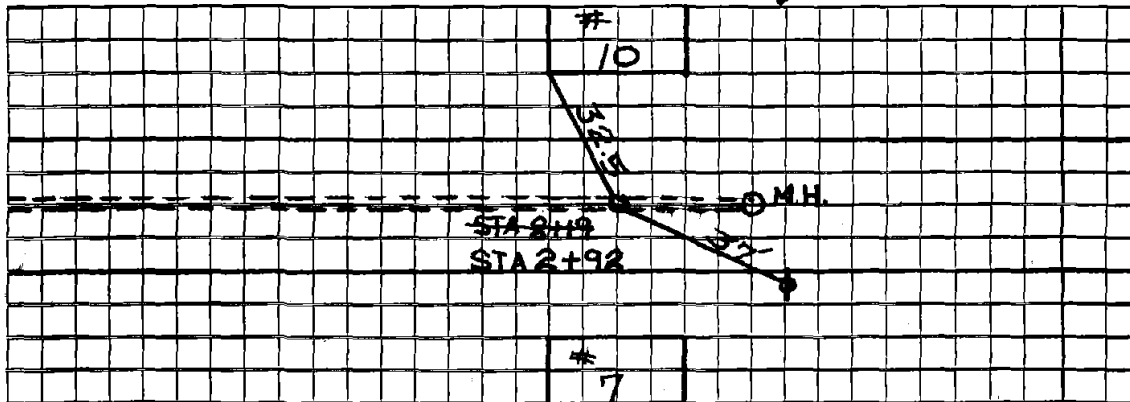

Connection made in..... Street.

Work completed.....19..

Remarks: