

Name Anthony J. DeRocco

Service No. 69

Address 8 Dunham Street

Location

Kind of Pipe

Size

Size of Main

~~Repair-Renewal~~ New ServiceLocation *Comm 8-3-59*

Date	Material	Amount	Total	Date	Amount
6-3-59	Labor 33.46			<i>5-27-59</i>	<i>300 00</i>
6-4-59	Labor 44.79			<i>8-5-59</i>	<i>24 79</i>
6-5-59	Labor 44.79	123.04			<del><i>24 79</i></del>
	10% O.H.	12.30	135.34		<i>275 21</i>
	86' 6" Transite pipe @.70		60.20		
	1 6" Duplex Adapter		1.90		
	2 6" 22 $\frac{1}{2}$ " Transite Bends @6.21		12.42		
	1 Cesspool Cover & Frame		10.50		
	300 Sewer Brick @4.20 per 100		12.60		
	3 bags Cement @1.50		4.50		
	1 ton Sand Brick		1.00		
	2 hrs. Pippin Shovel @4.50		9.00		
	3 hrs. Labor Town Shovel @6.50		19.50		
	3 hr. Trucking@@.75		2.25		
	2 hrs. Loader @3.00		6.00		
			<u>275.21</u>		

# TOWN OF LEXINGTON—DEPT. OF PUBLIC WORKS

## SEWER DIVISION

DATE .....

NO. ....

The undersigned applies for the construction of a particular sewer connecting No. ....  
 Street and hereby agrees to comply with the Rules and Regulations governing the construction and use of Particular  
 Sewers, as now or at any future time established by the Board of Selectmen.


Am't of estimate \$.....

Am't Paid \$.....

..... Owner

Sketch of Service Here

8

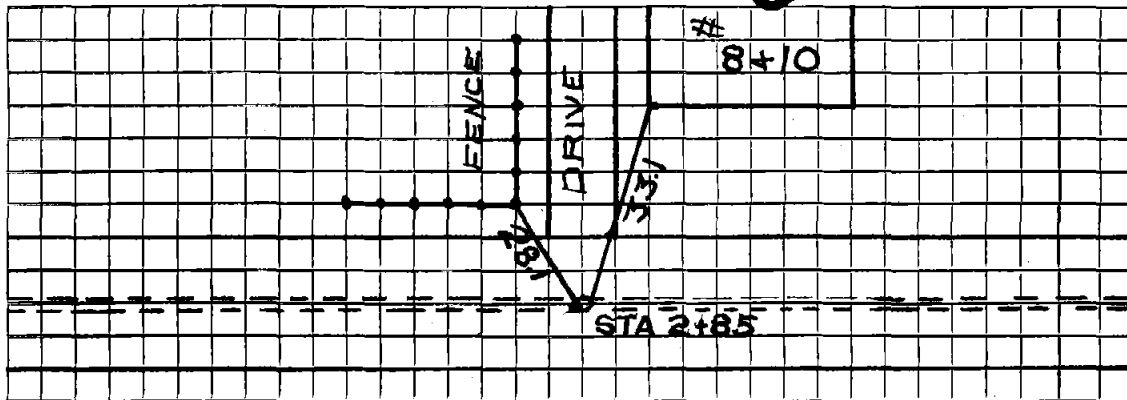

Connection made in ..... Street.

Work completed ..... 19..

Remarks: