

Name James Razzono

Service No. 103

Address 24 Earl St.

Location

Kind of Pipe

Size

Size of Main

Repair—Renewal—New Service WO #5119 Kel-Scot #2891

Location MAY 9 1977

Date	Material	Amount	Total	Date	Amount
11/29/76	labor	77.45		11-29-76	350.00
	10%OH	7.75	85.20	5-9-77	101.64
1	6" X 10' trans. pipe @ 1.75		17.50		148.36
1	6" X 5' trans. pipe @ 2.03		10.15		
1	6" 90° elbow		6.56	12/21/76	labor
1	6" X 2' nipple		5.39	1	6" X 10' trans. pipe
10	red bricks @ .12		1.20	1	6" X 5' trans. pipe
1/2	bag cement		1.50	1/2	bag cement
2	yds. gravel @ 2.18		4.36	12	red bricks
1/2	hr. trucking @ 3.00		1.50	1/2	hr. trucking @ 3.00
2	hr. shovel @ 6.50		13.00		
1/2	hr. loader @ 4.00		2.00		
			148.36		
12/20/76	42.5' 6" transite pipe				
	10' 4" cast iron				

Deposit

Retard

OUTSIDE

Apply 79.50 to WTC #70


DATE _____

TOWN OF LEXINGTON — BOARD OF PUBLIC WORKS

SEWER DIVISION

Sketch of Service Here

24

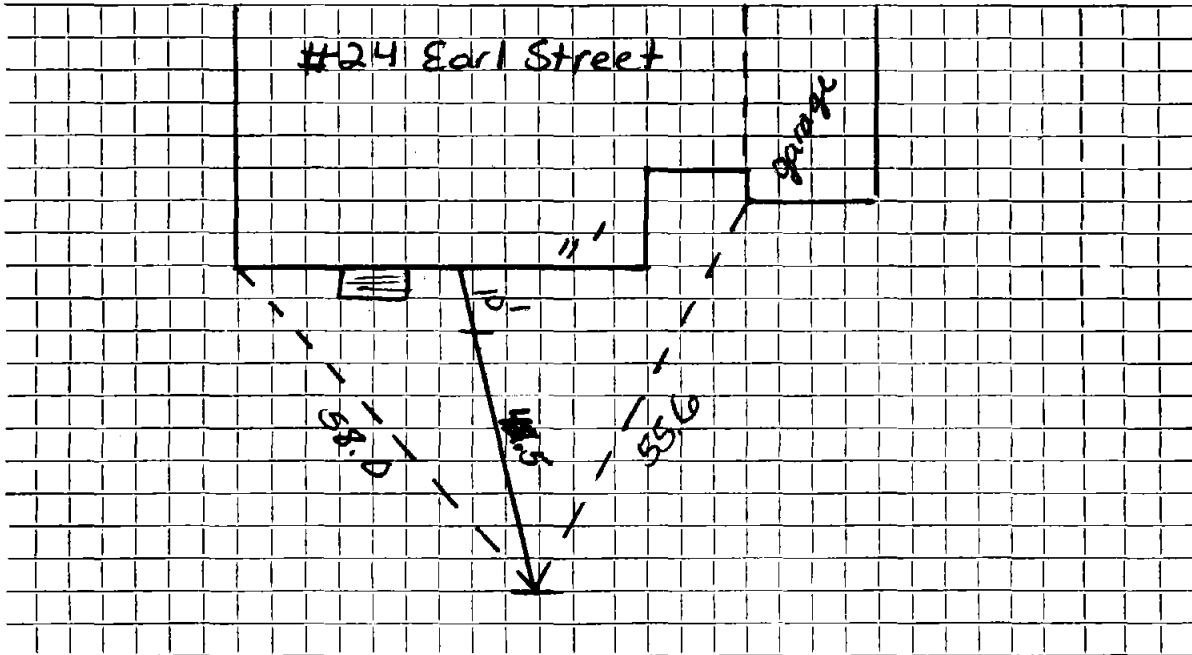

Connection made in Street. Work completed

Remarks:
.....
.....