

Name Thomas Small

Service No. 269

Address 26 Earle Street

Location

Kind of Pipe

Size

Size of Main

~~Repair/Replacement~~ **New Service**

Location Comm 76-61


Date	Material	Amount	Total	Date		Amount
2-6-60	Labor	42.24		11-29-61	Deposit	150.00
	10% O.H.	4.22	46.46	3-6-61	Retard	29.78
	57' 6" Transite pipe @.78		44.46			120.22
	1 6" 900 Transite Elbow		5.40			
	1 6" Duplex Adapter		1.90			
	2 hrs. Towm Shovel @6.50		13.00			
	2 hrs. Trucking @3.00		6.00			
	1 hr. Loader @3.00		3.00			
			120.22			

DAT ~~\_\_\_\_\_~~

TOWN OF LEXINGTON — BOARD OF PUBLIC WORKS

SEWER DIVISION

Sketch of Service Here

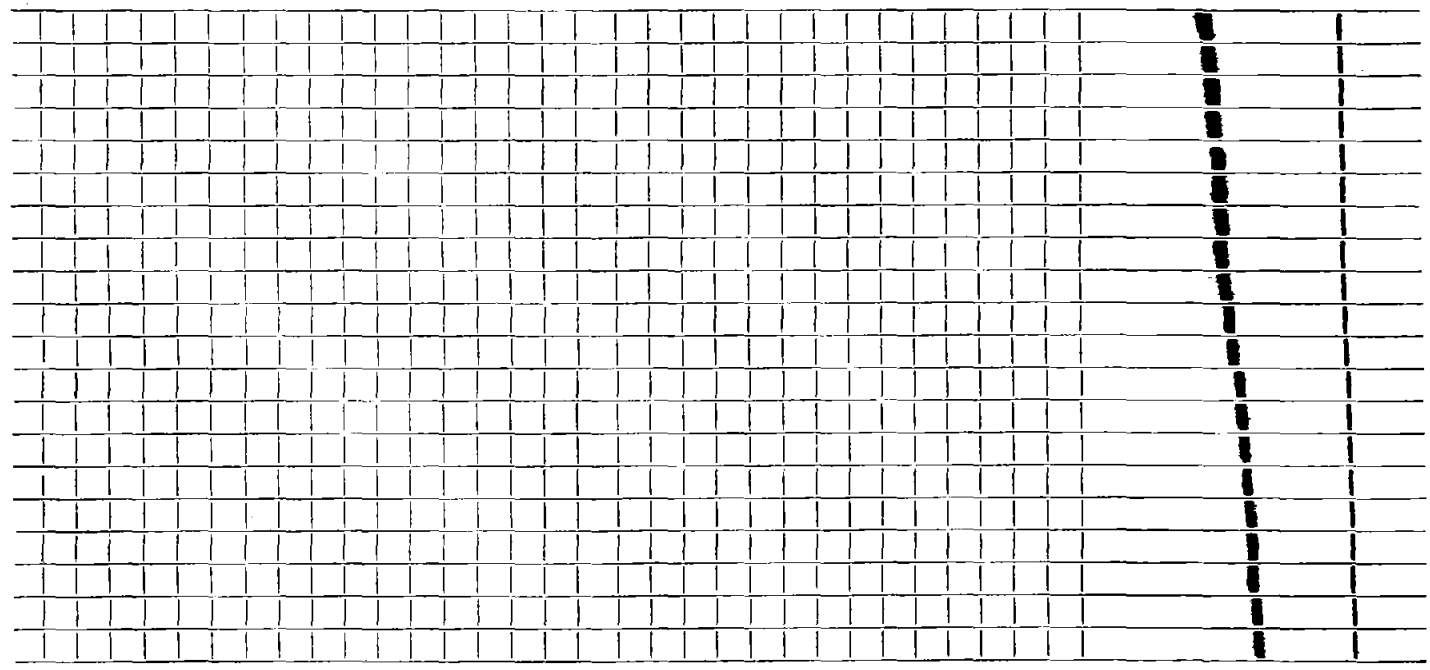

Connection made in ..... Street.                      Work completed ..... — — — — —

Remarks: ..... — — — — —  
..... — — — — —  
..... — — — — —