




DATE SEPT 1999

TOWN OF LEXINGTON — BOARD OF PUBLIC WORKS  
SEWER DIVISION

Sketch of Service Here

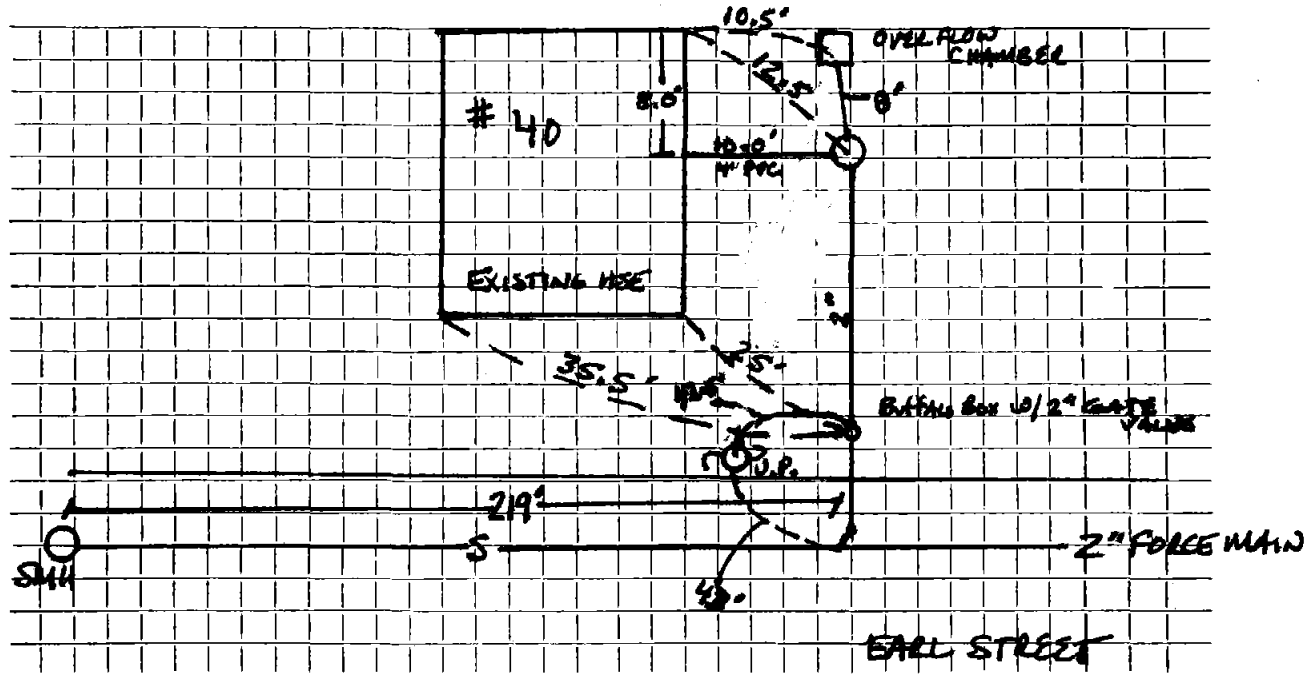

Connection made in ..... Street. Work completed .....

Remarks: CENTER PUMP CHAMBER TO COVER OVERFLOW TRUNK = 8.0'

BACKFLOW VALVE @ CURB GATE ON HOUSE SIDE

BACKFLOW VALVE ON PUMP CHAMBER ON OUTSIDE