

Name

Service No.

Address 43 EARL ST

Location

Kind of Pipe

Size

Size of Main

Repair—Renewal—New Service

Location


Date		Material	Amount		Total		Date		Amount
6/22	00	1 1/4" 6" PVC 1 CLEAN OUT							
		10' 4" PVC							

SERVICE
GO'S OUT REAR
ON WARD ST

DATE _____

TOWN OF LEXINGTON — BOARD OF PUBLIC WORKS
SEWER DIVISION

Sketch of Service Here

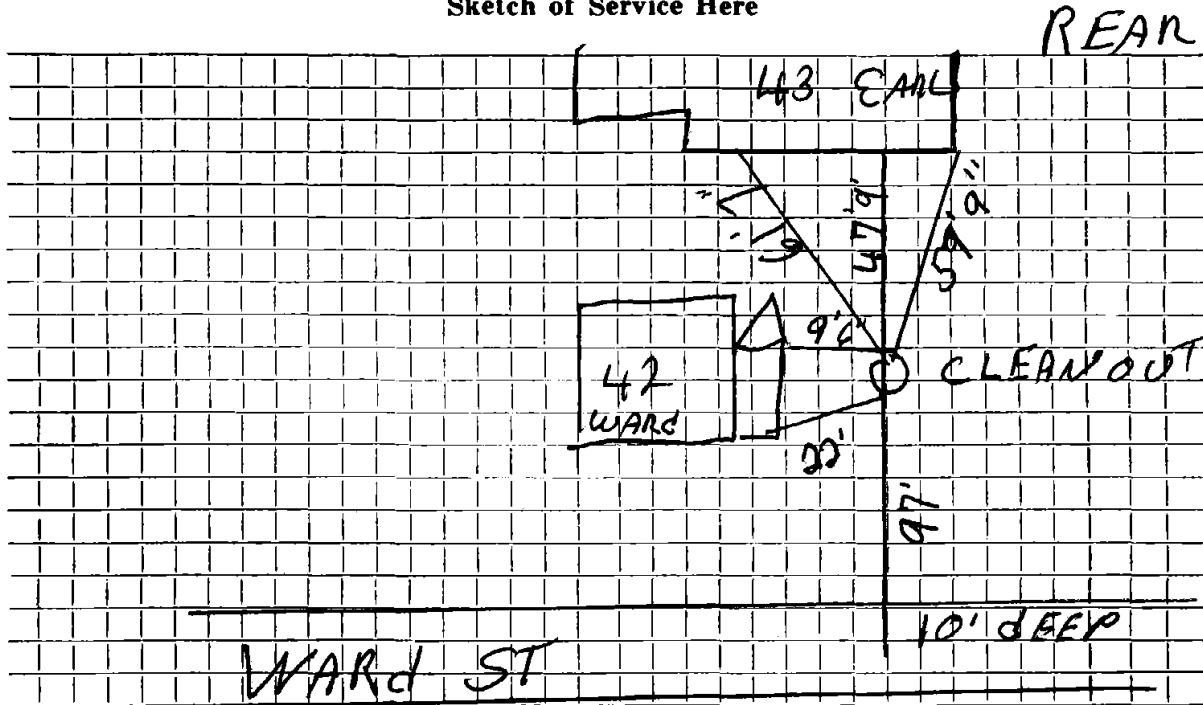

Connection made in Street. Work completed


Remarks:

.....
.....

DATE SEPT 1999

TOWN OF LEXINGTON — BOARD OF PUBLIC WORKS
SEWER DIVISION

Sketch of Service Here

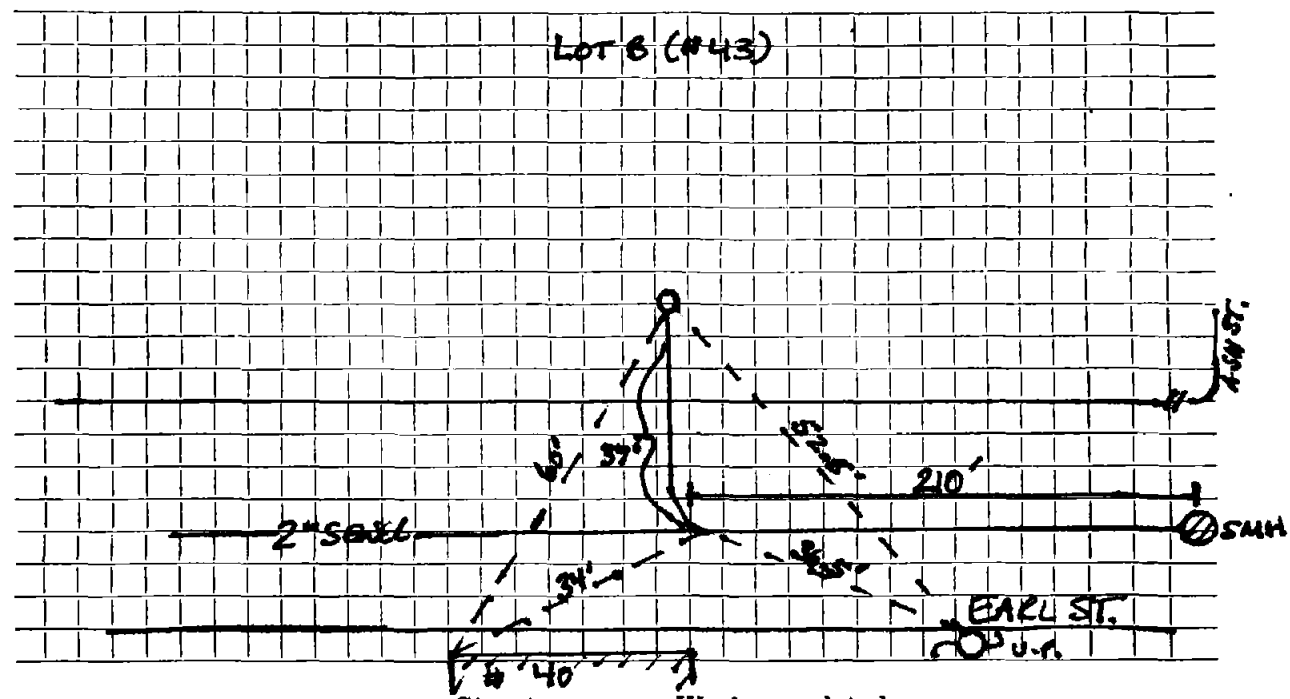

Connection made in Street. Work completed

Remarks:
..... SERVICE NOT USED GO'S TO W AND ST FROM BACK
..... OF HOUSE