


DATE SEPT 1999

TOWN OF LEXINGTON — BOARD OF PUBLIC WORKS

SEWER DIVISION

Sketch of Service Here

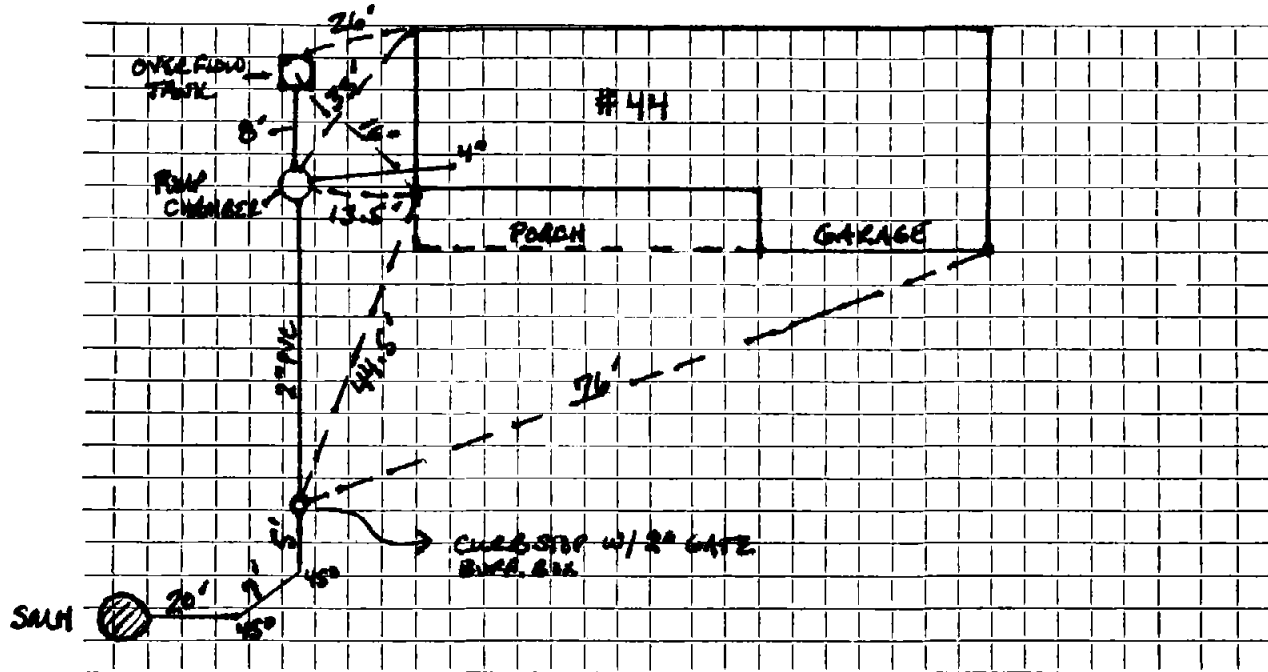

Connection made in Street. Work completed

Remarks: BACKFLOW VALVE @ GATE VALVE ON HOUSE SIDE
BACKFLOW VALVE @ PUMP CHAMBER ON OUTSIDE