

Name Reescott Village Realty

Service No.

Address # 115 East Emerson Rd.

Location

Lot 25

Kind of Pipe

PVC

Size

6"

Size of Main

8"

Repair—Renewal—New Service

Bicentennial Bldg. #4223

Location

Date

Material

Amount

Total

Date

Amount

~~1984~~ ~~37.5' of 6" PVC~~

~~N/C~~


'84'

37.5' 6" P.V.C.

DATE \_\_\_\_\_

TOWN OF LEXINGTON — BOARD OF PUBLIC WORKS  
SEWER DIVISION

Sketch of Service Here

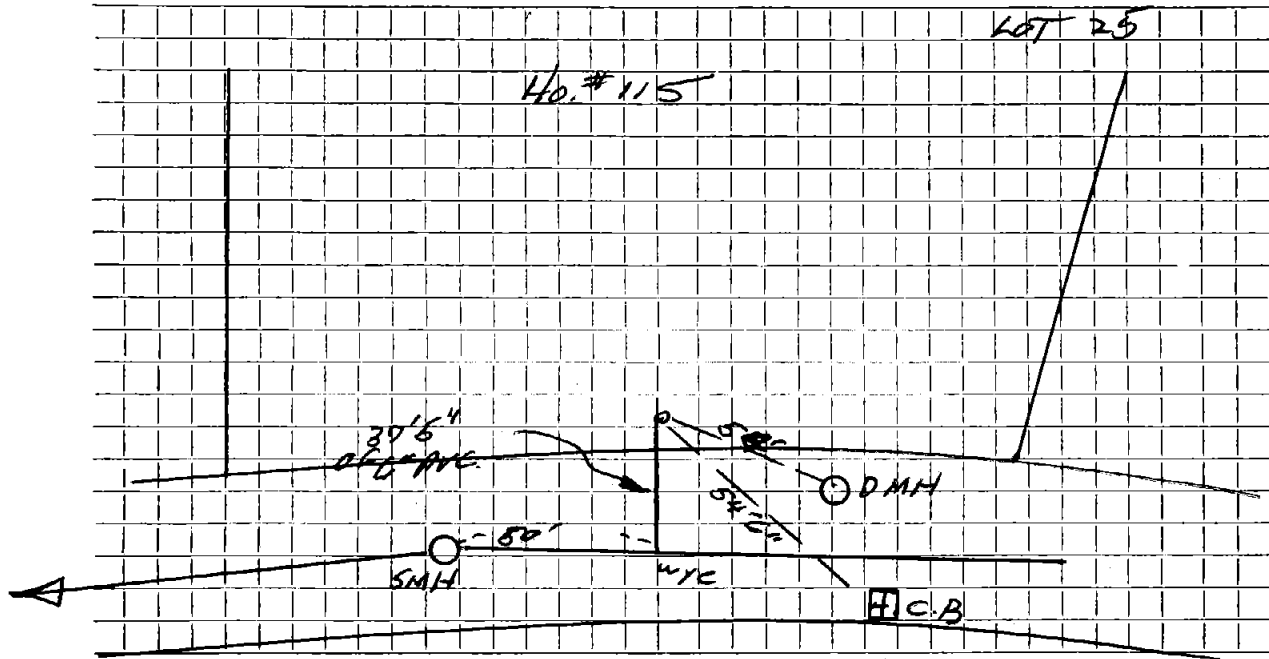

Connection made in EAST EMERSON Street. Work completed .....

Remarks: NO INSPECTION; NO TIES .....

.....  
.....