

Name

Service No.

Address #116 East Emerson Rd.

Location

LOT 29

Kind of Pipe PVL

Size 6"

Size of Main 8"

Repair—Renewal (New Service)

Location

Date	Material	Amount	Total	Date	Amount
	<del>① Wye 8x6"</del>				
	<del>① 22° bend</del>				
	<del>20 ft. 6" PVC.</del>				
				20' 6" P.V.C.	
12/16/88	① 22° bend			1 6"-22° Bend	
	15' 6" 6" PVC.			1 6"x8" Wye	
	① Ferraco 4x6"				
	7' 6" 4" C.I.				

DATE \_\_\_\_\_

TOWN OF LEXINGTON — BOARD OF PUBLIC WORKS


SEWER DIVISION

Sketch of Service Here

116

#116 East Emerson Rd

Lot 29

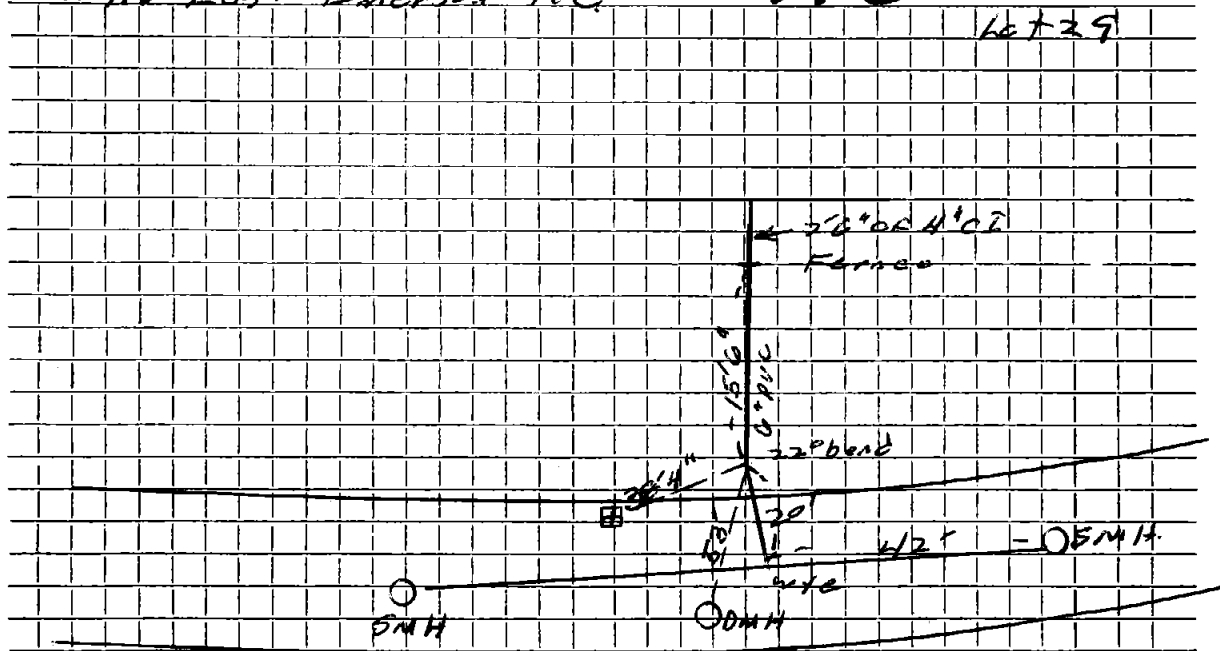

Connection made in ..... Street. Work completed .....

Remarks: .....

.....  
.....