

Name Prescott Village Realty Trust

Service No.

Address 129 EAST EMERSON

Location

Kind of Pipe

Size

Size of Main

Repair—Renewal—New Service New Service McKee #4638

Location

Date

Material

Amount

Total

Date

Amount

~~4/84~~

~~8" WYE
34 LF 6" PVC~~

11- - 84

7/86

5 LF 4" PVC
30 LF 6" PVC
4" X 6" FERNCO


34' 6" P.V.C.
1 8" X 6" Wye

DATE _____

TOWN OF LEXINGTON — BOARD OF PUBLIC WORKS

SEWER DIVISION

Sketch of Service Here **129**

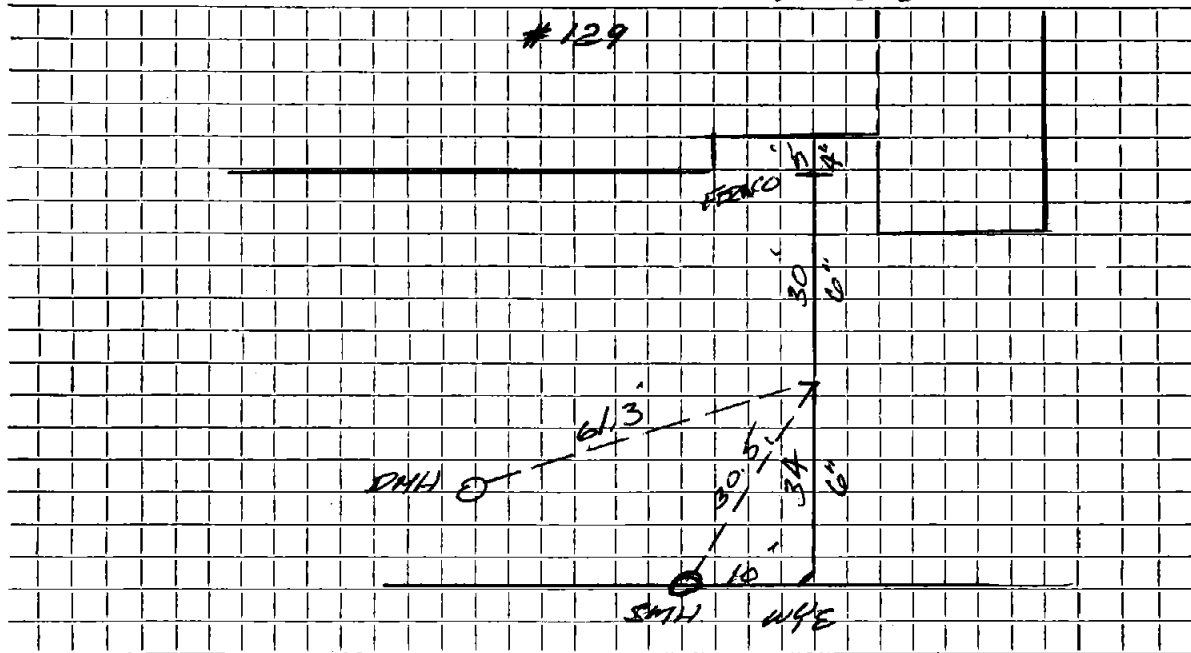

Connection made in EAST EMERSON Street. Work completed

Remarks:

.....