


DATE _____

TOWN OF LEXINGTON — BOARD OF PUBLIC WORKS

SEWER DIVISION

Sketch of Service Here

130

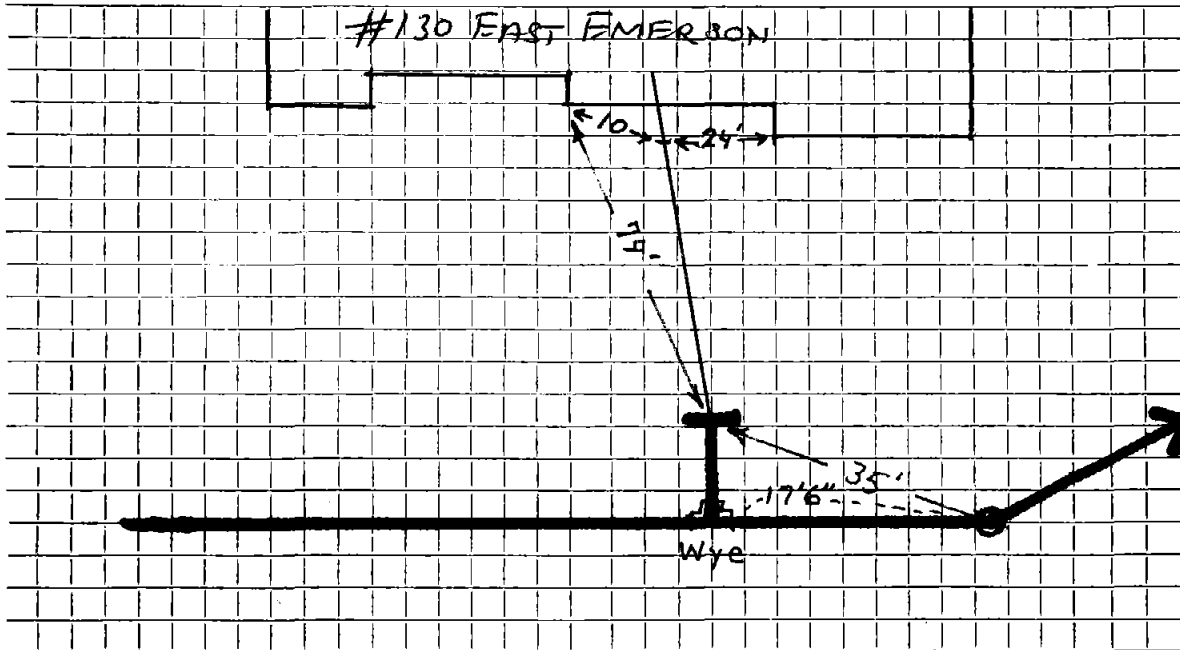

Connection made in Street.

Work completed JUNE 1985

Remarks:

.....

.....